


T.11S., R.1E., W.M.

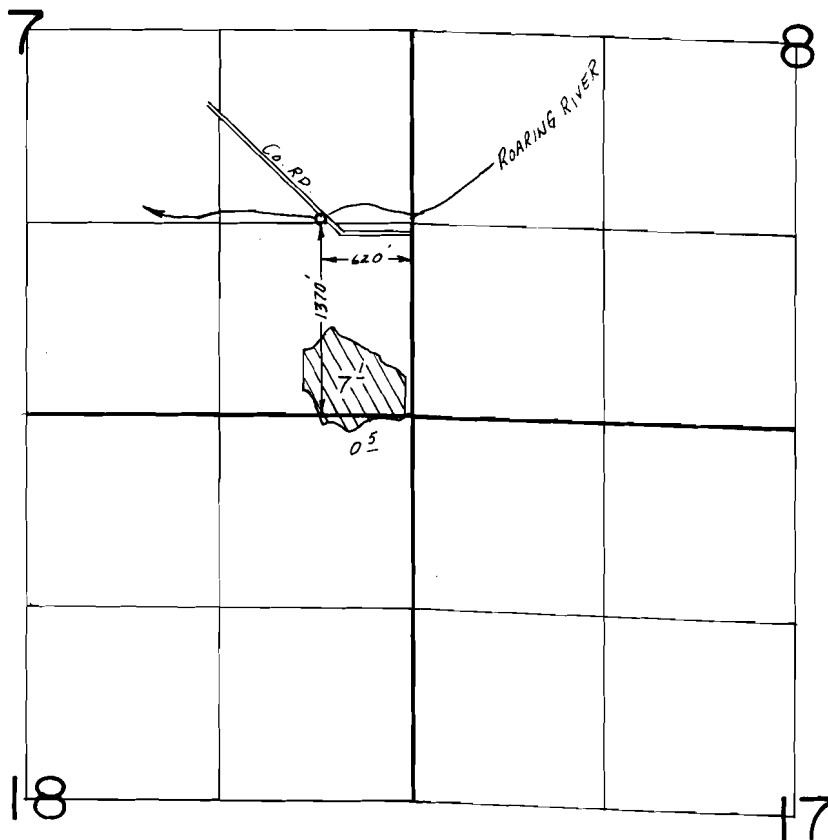

SCALE: 1" = 1320'

FINAL PROOF SURVEY UNDER

Application No. 60202.. Permit No. 44962.....
IN NAME OF

DONALD J. & JOANN M. SAPAUGH

Surveyed Sept. 6.... 19.85, by J.M. WARREN.....