


# T. 11 S., R. 3 W., W.M.

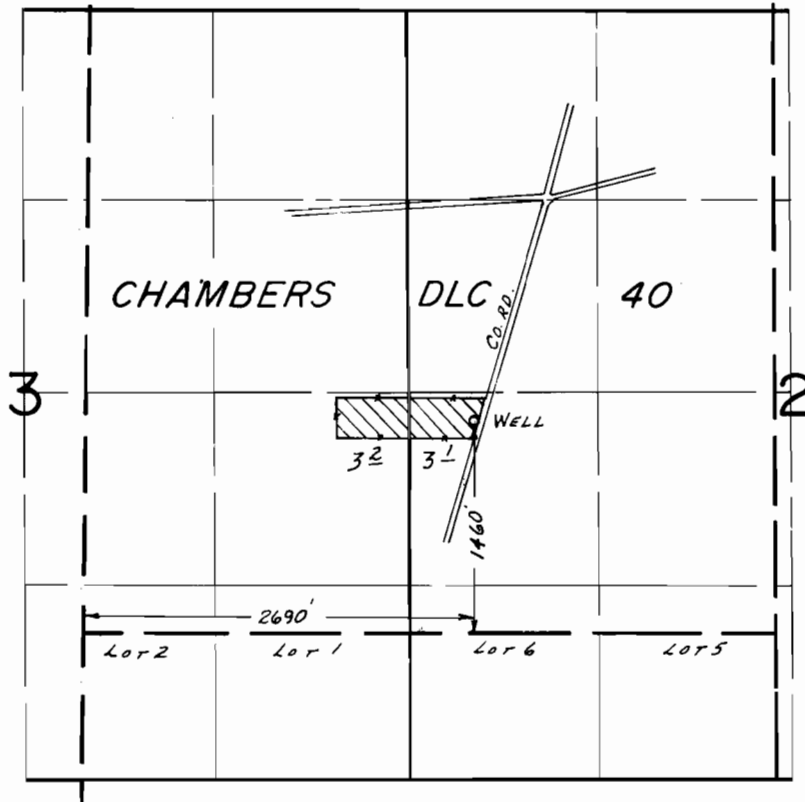

SCALE: 1" = 1320'

## FINAL PROOF SURVEY UNDER

Application No. G-6836 Permit No. G-6329.....  
IN NAME OF

.....WARD LEDBETTER.....

Surveyed Apr. 24, 1979, by S. C. BROWN.....