


T.9S., R.3E., W.M.

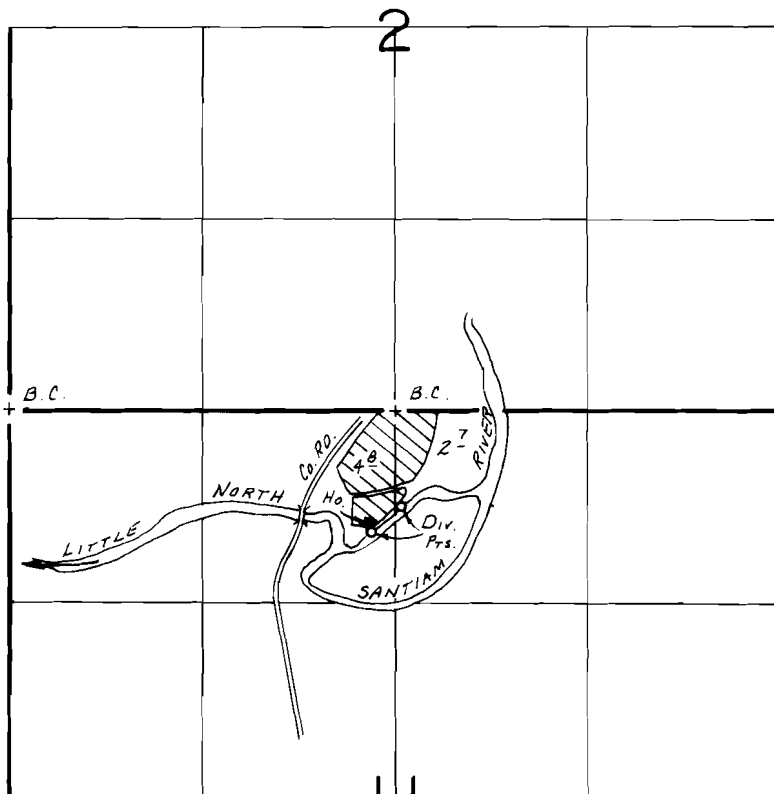

DIV. PTS. LOC.: 660'S. & 40'E. ALSO 840'S. & 160'W, BOTH FROM N 1/4 COR. SEC. 11.

SCALE: 1" = 1320'

FINAL PROOF SURVEY UNDER

Application No. 58147.... Permit No. 43923.....
IN NAME OF

..... ERVIN DALE JOHNSON

Surveyed April 25.. 19.85, by P.R. PAGTER.....