


T. 9S., R. 2E., W.M.

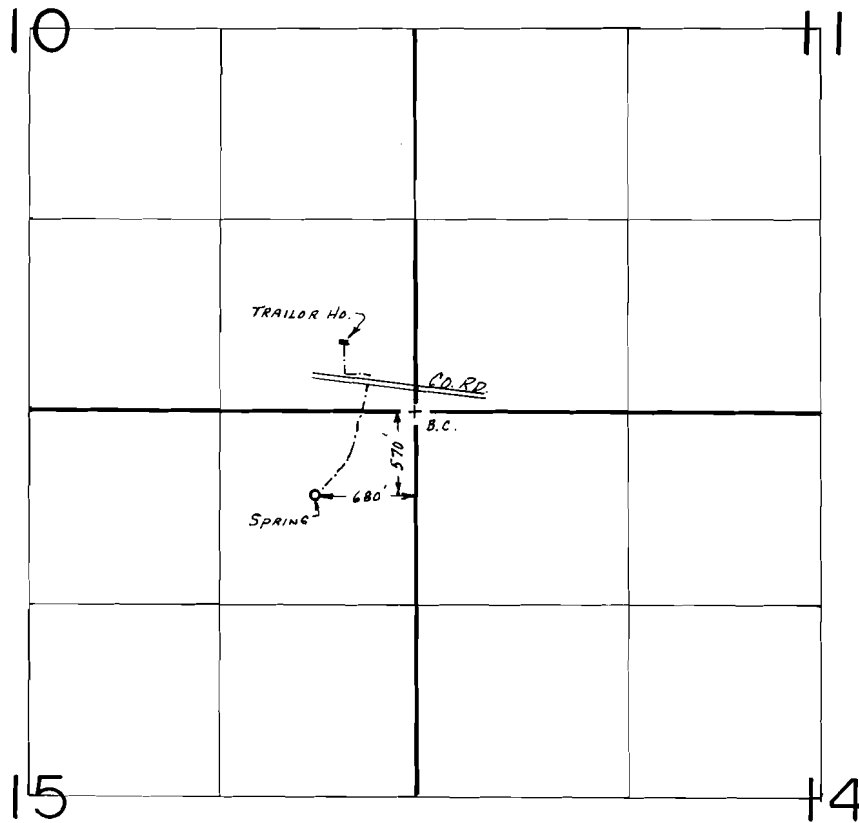

SCALE: 1" = 1320

FINAL PROOF SURVEY UNDER

Application No. 60287... Permit No. 44963.....
IN NAME OF

.....VINCENT L. MILLIGAN.....

Surveyed May. 14..... 19.85., by T. M. WARREN.....