


T.4S.,R.1W.,W.M.

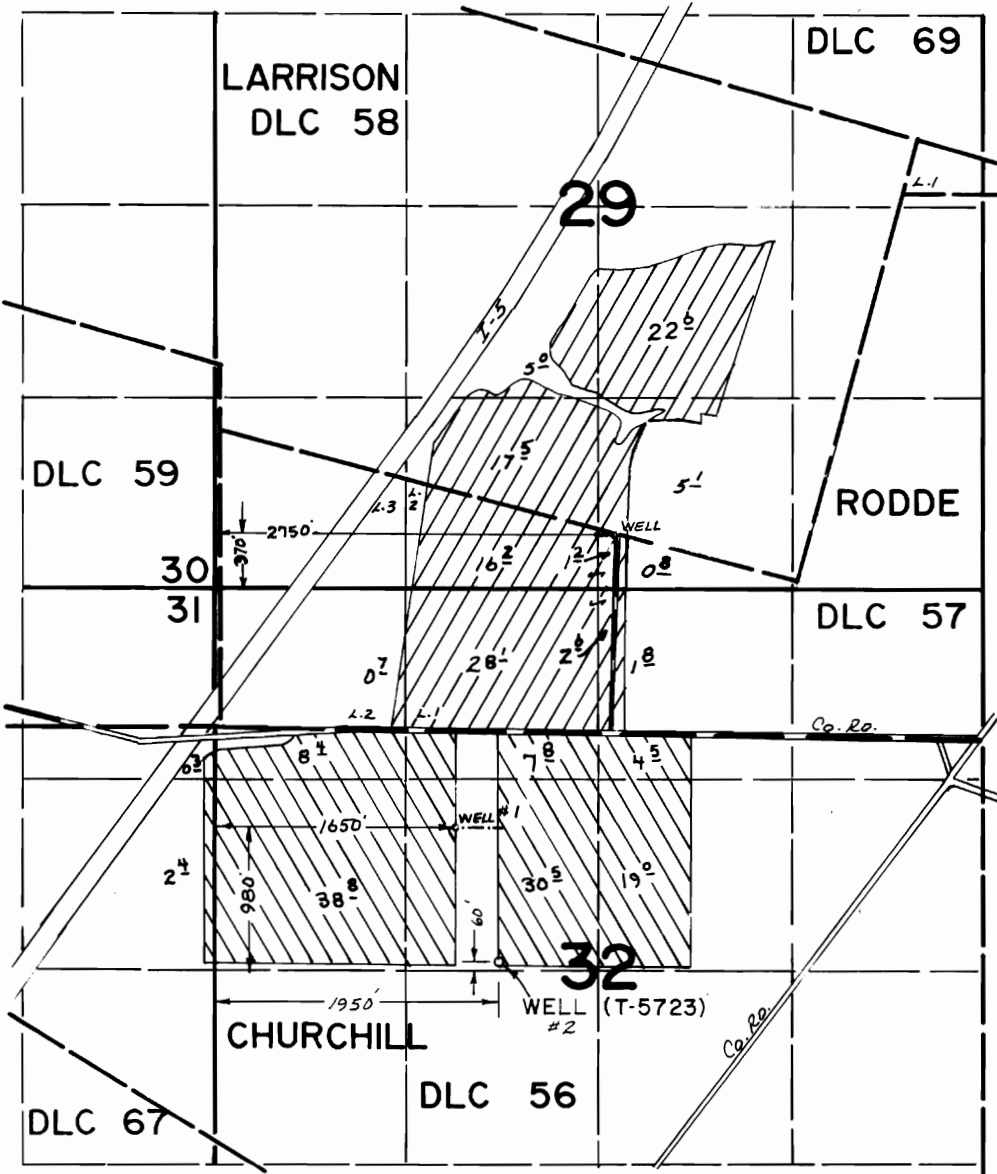

SCALE: 1" = 1320'

FINAL PROOF SURVEY UNDER

Transfer No. 5723

G-5806

G-5567

Application No. G-5807. Permit No. G-5568

IN NAME OF



TOM DEARMOND

Surveyed APRIL 20, 1976, by L. Toll
 Mar. 20 1986 T.M. WARREN (T-5723)

T-5723 ADDED
 4/3/86 BNB

DFN-ILL-48
 DFN-ILL-50