


T. 7S., R. 1W., W. M.

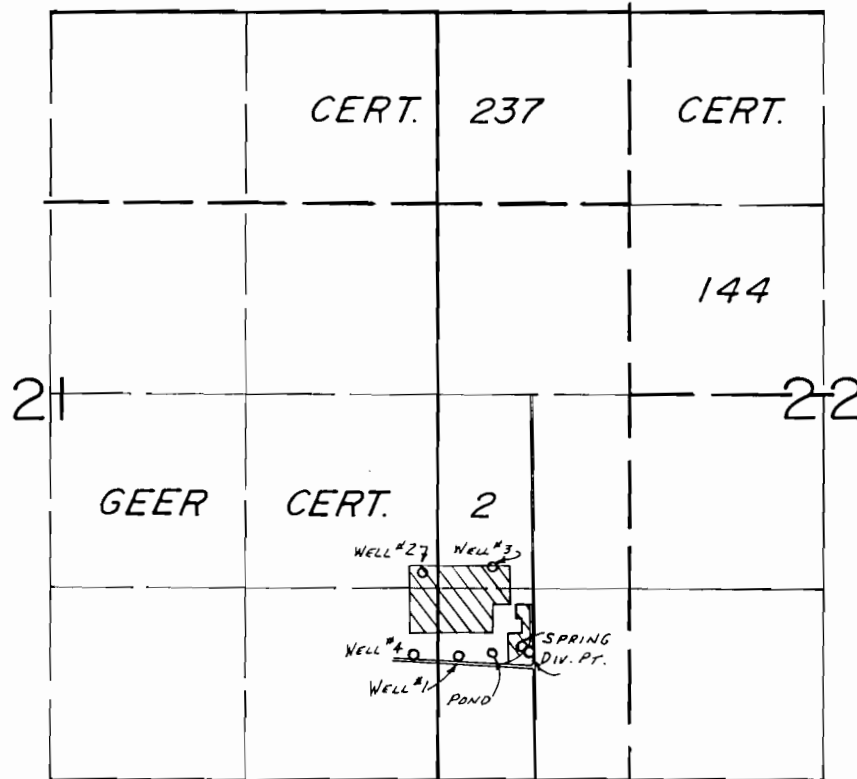

WELLS Loc.: #1- 840' N. § 150' E., #2- 1420' N. § 100' W., #3- 1460' N. § 370' E.,  
#4- 850' N. § 160' W., SPRING Loc.: 920' N. § 580' E., DIV. PT- 870' N. § 640' E.,  
ALL FROM SE COR. SEC. 21.



GREENHOUSES

SCALE: 1"=1320'

## FINAL PROOF SURVEY UNDER

G-10501

G-9743

G-11408

G-10536

Application No. 68420. Permit No. 49488.....

IN NAME OF

FRANKLIN HENRY KOCH

Surveyed June 6, 1984, by B.W. BISHOP  
Apr. 18, 1986 T.M. WARREN

INSPECTION,  
CHAIN SURVEY &  
DEFN- 10-37

5/5/86

BWB