


T. 5S., R. 2W., W.M.

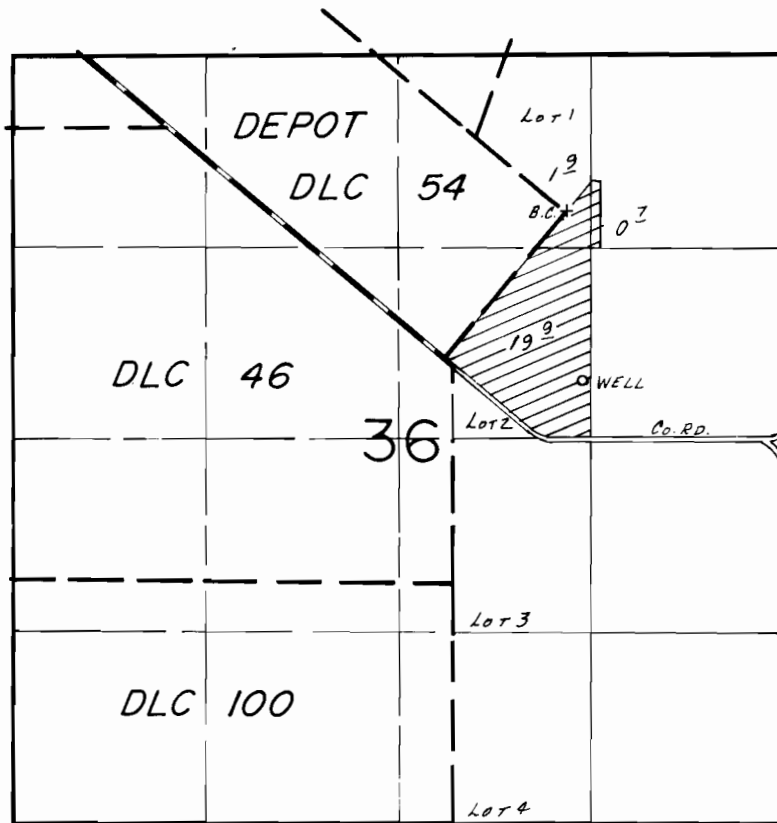

WELL LOC.: 116.0 S. & 100 E. FROM E. COR. DEPOT DLC 54.

SCALE: 1" = 1320'

FINAL PROOF SURVEY
UNDER

Application No. G-10716. Permit No. G-9951.....
IN NAME OF

.....ALBERT PRANTL.....

Surveyed Mar. 21.... 19.86, by T.M. WARREN....