


T.8S., R.2W., W.M.

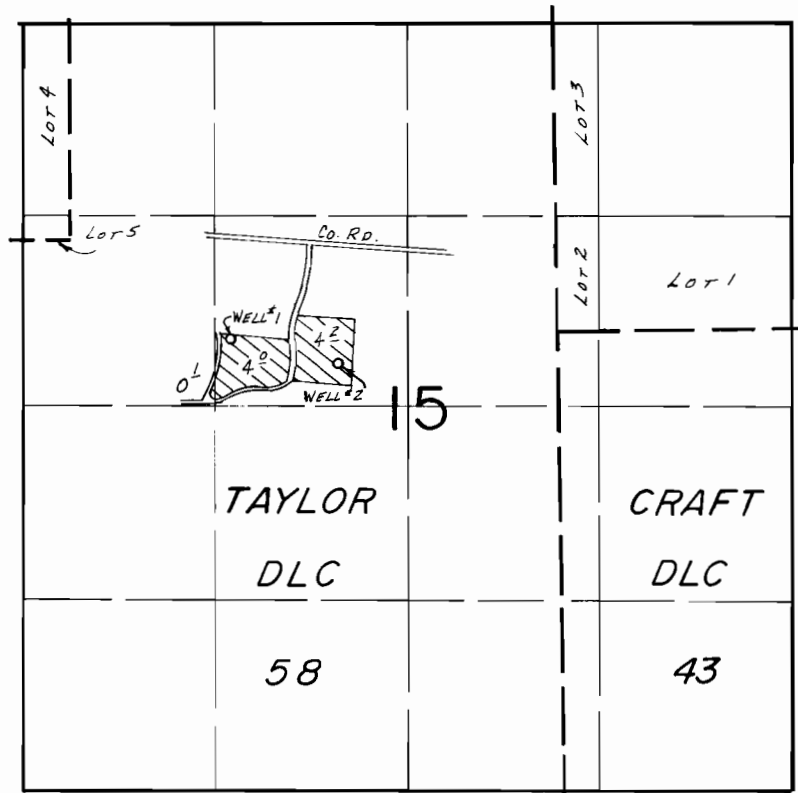

WELLS LOC.: #1- 50'S. & 2250' W., #2- 200'S. & 1500' W. BOTH FROM NW COR. CRAFT DLC 43.

SCALE: 1" = 1320'

FINAL PROOF SURVEY UNDER

Application No. G-11297 Permit No. G-10416
IN NAME OF

DELMER L. & LOIS M. BARBER

Surveyed May 14, 1985, by T.M. WARREN