


T.1S., R.5E., W.M.

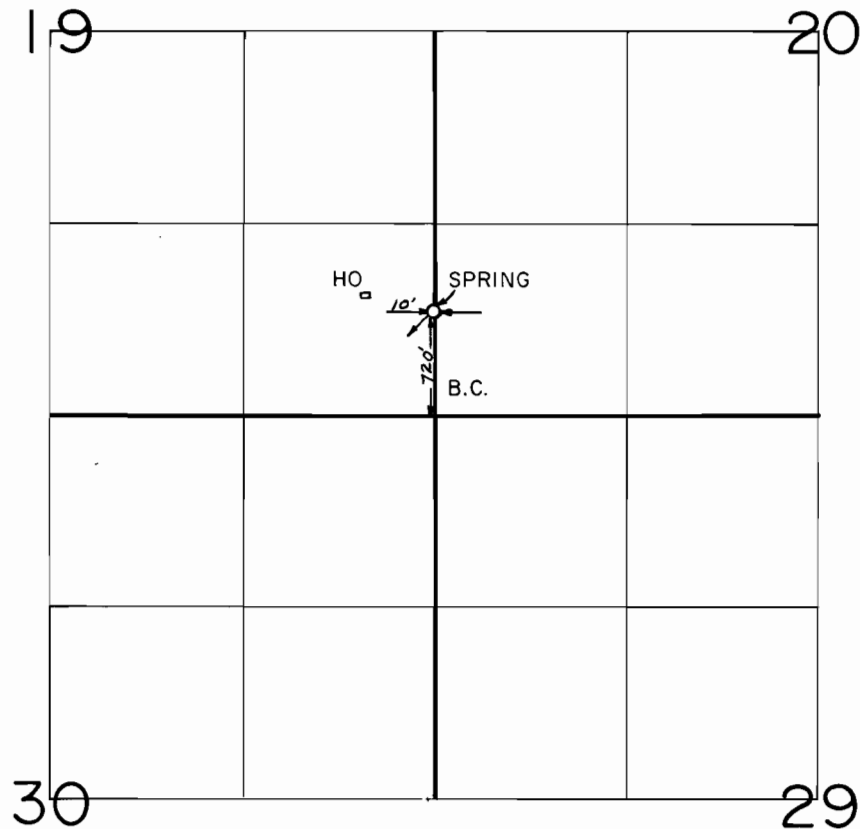

SCALE 1" = 1320'

FINAL PROOF SURVEY
UNDER

Application No. 59693 Permit No. 45863
IN NAME OF

HENRY J. DOLAN

Surveyed MAY 5, 1984, by P. R. PAGTER