


T.1S., R.4E., W.M.

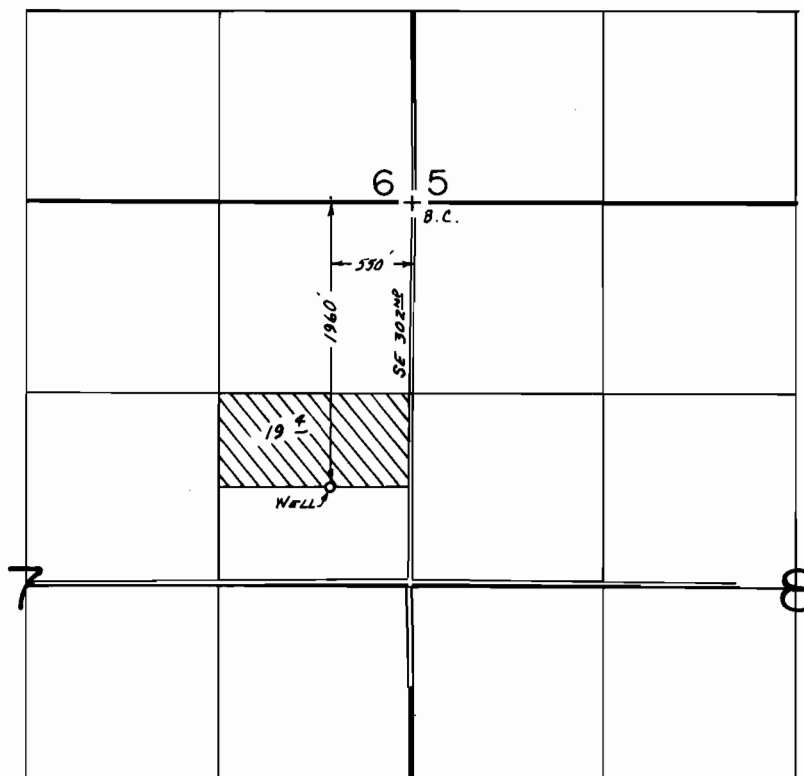

SCALE: 1"=1320'

FINAL PROOF SURVEY UNDER

Application No. G-10602 Permit No. G-9616.....
IN NAME OF

JAMES A. FARLEY.....

Surveyed May 1..... 1984, by P.R. PAGTER.....