


PR 7388

T. 2N., R. 12E., W.M.

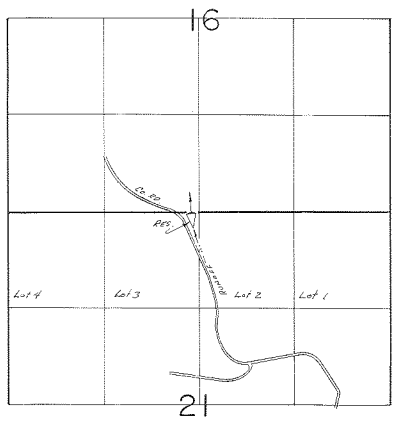

SCALE: 1" = 1320'

**FINAL PROOF SURVEY**  
UNDER

Application No. R-67549 Permit No. R-9388...  
IN NAME OF

..... J. THOMAS WILDS .....

Surveyed June 20, 1984, by L. M. TOLL .....