


T. 2 S., R. 2 W., W.M.

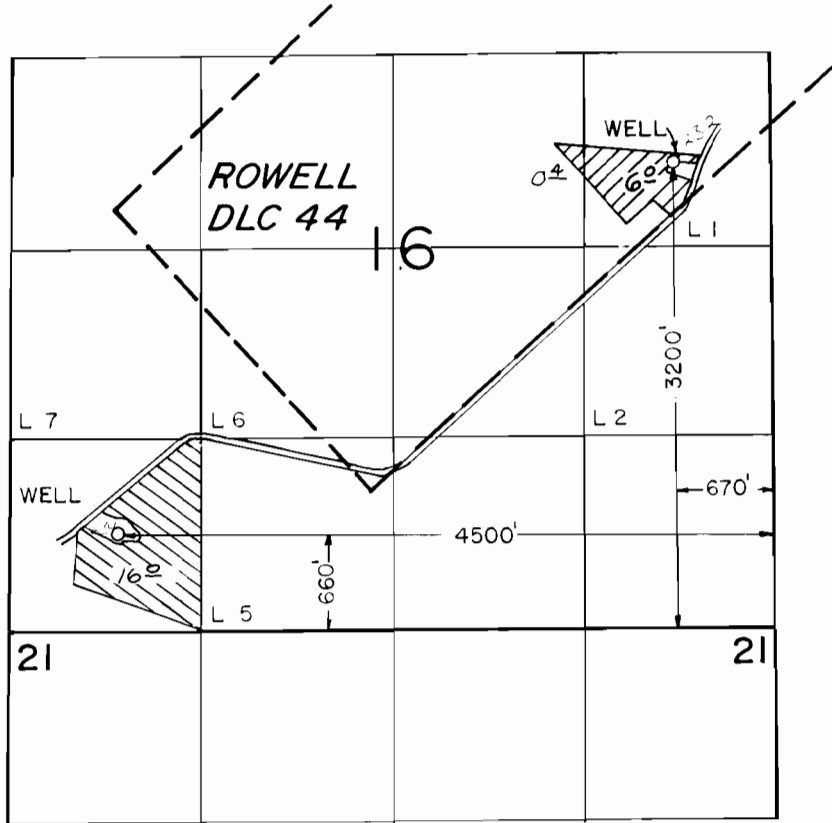

FINAL PROOF SURVEY

UNDER

SCALE 1" = 1320'

Application No. G-8160 Permit No. G-7519 
 G-8158 Permit No. G-7518 

IN NAME OF
TIM D. DAVIS

Surveyed JULY 29 19 85, by T. M. WARREN