


T-3189

SPOR V.28 P406

T.7S.,R.24E.,W.M.

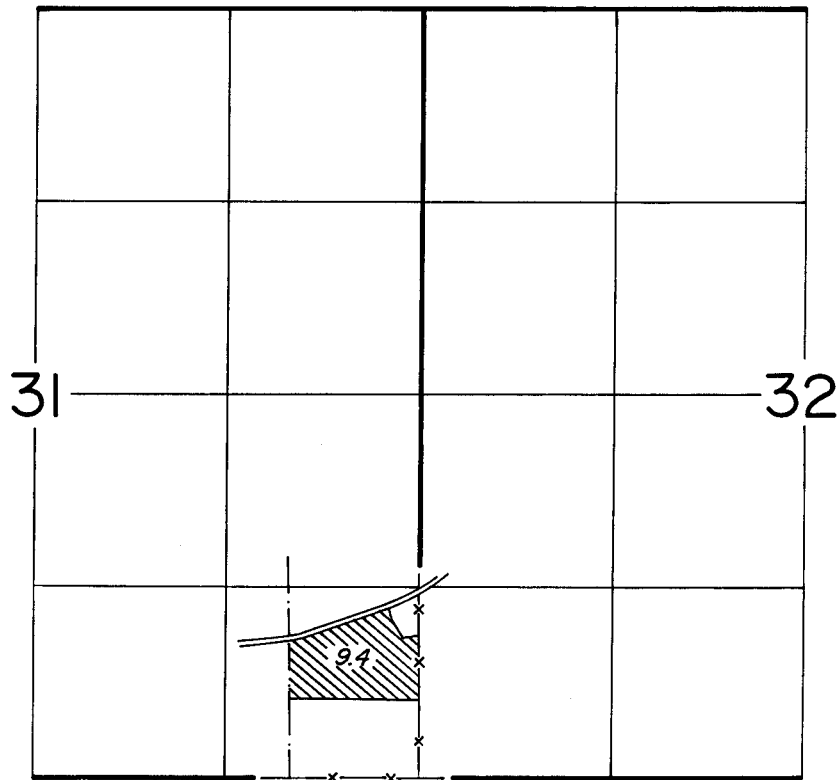

FINAL PROOF SURVEY
UNDER

TRANSFER NO. 3189

IN NAME OF

.....Michael F. Vandehey.....

Surveyed SEPT. 12, 1979, by *dBow*.....