


T. 8S., R. 39E., W.M.

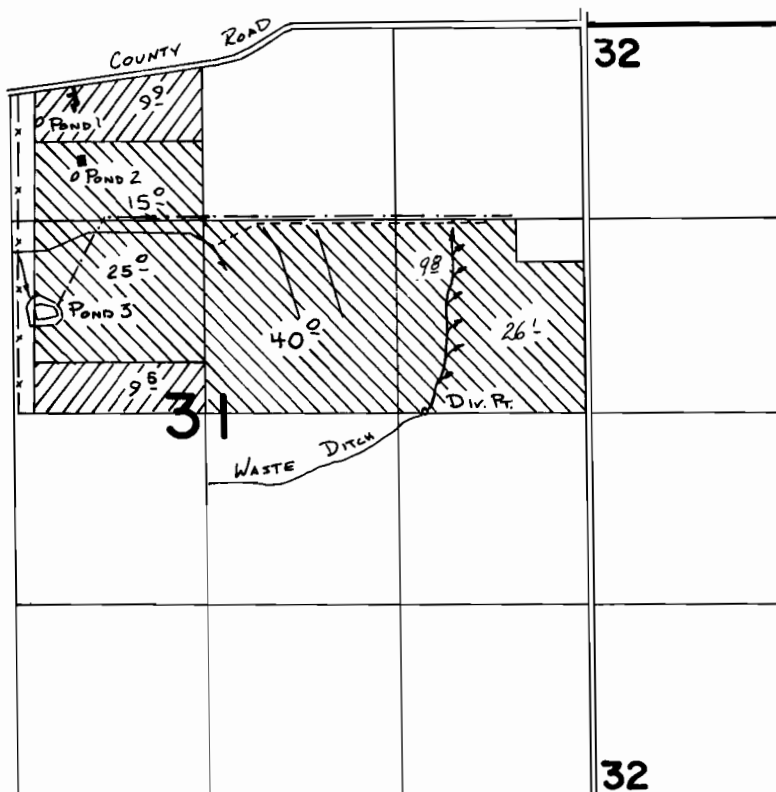

Pond 1 Loc: 2000' N. & 1120' W. FROM CENTER COR. SEC. 31
 Pond 2 Loc: 1630' N. & 870' W. FROM CENTER COR. SEC. 31
 Pond 3 Loc: 720' N. & 1100' W. FROM CENTER COR. SEC. 31
 Div. R. Loc: 1500' E FROM CENTER COR. SEC. 31



SUPP'L



PRIM.

FINAL PROOF SURVEY UNDER

SCALE: 1" = 1320'

Application No. **52720** Permit No. **39831**....
 IN NAME OF

DEAL J. & ARLENE A. SPRIET...

Surveyed 6-5-1978, by R. BARWIN.....