


T.18S. R.46E. W.M.

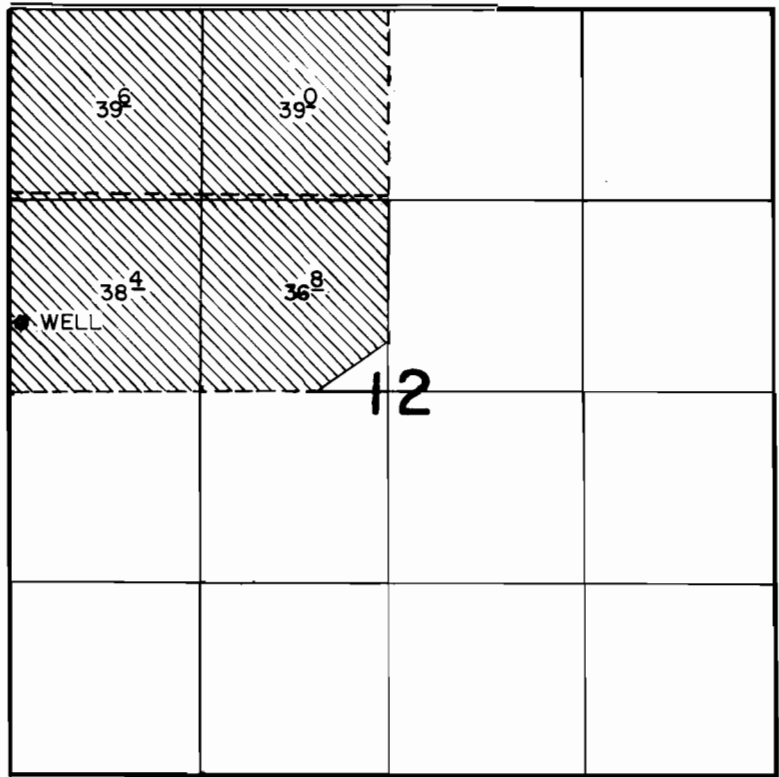

WELL Loc: 2170'S. & 60'E. fr. N.W. Cor. SEC. 12.

**FINAL PROOF SURVEY**  
UNDER

Application No. G-7354. Permit No. G-6809  
IN NAME OF

**BUTLER LAND & LIVESTOCK CO.**

Surveyed Aug. 3, 1979, by C. L. HUGHES...