
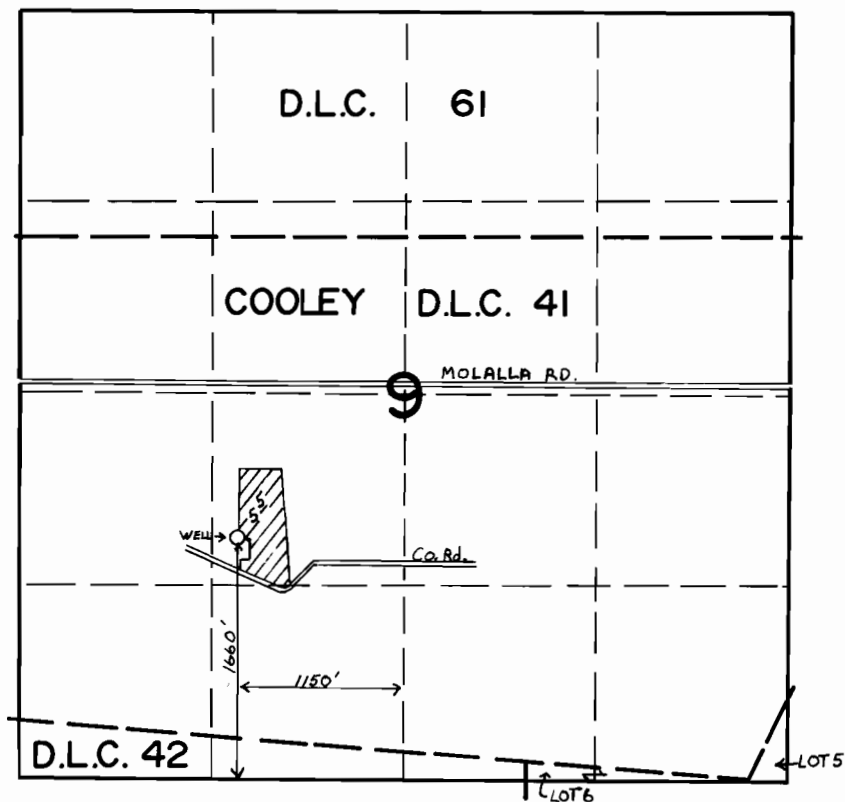


# T. 5S., R. 1W., W.M.

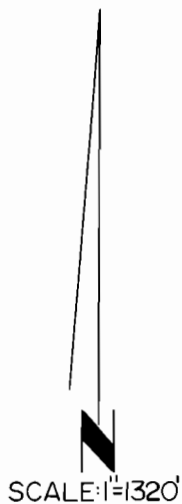

## FINAL PROOF SURVEY UNDER

Application No. G-9878. Permit No. G-9045.....  
IN NAME OF

**ISAAK BASARGIN**

Surveyed Aug. 28..... 1985... by B.W. BISHOP.....