


T. 15., R. 32&33E., W.M.

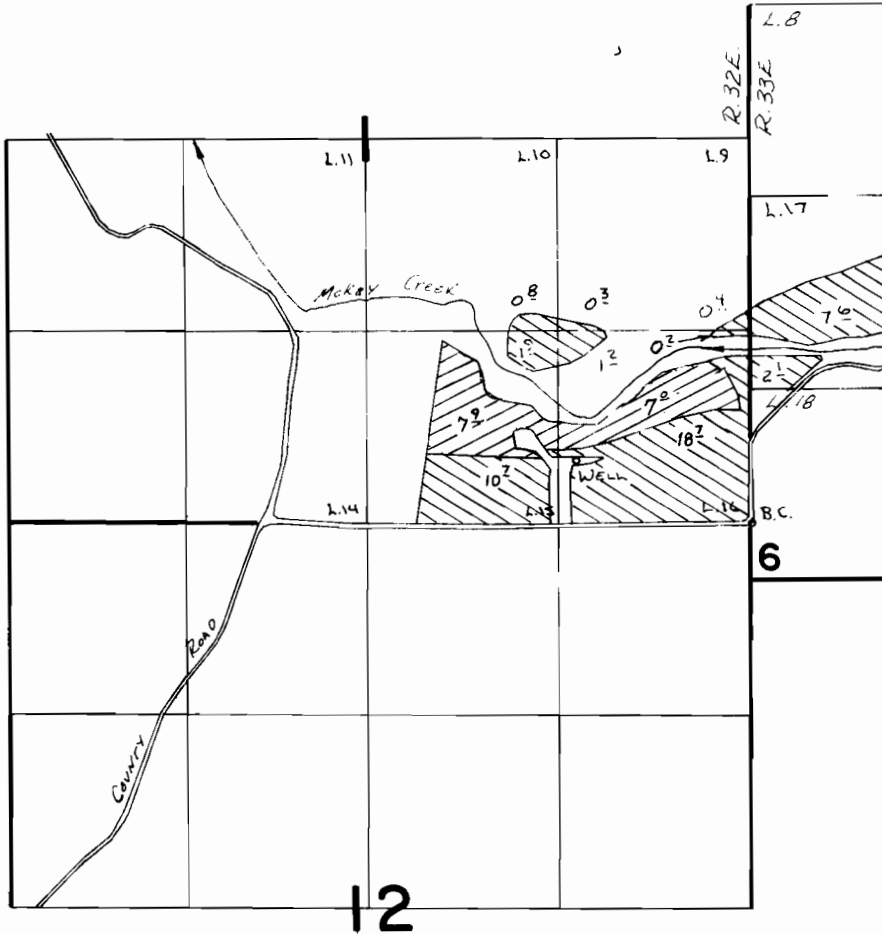

Scale 1"=1320'

WELL LOCATED 440' N & 1200' W. FROM SE COR. SEC. 1



PRIMARY



SUPPLEMENTAL

**FINAL PROOF SURVEY**  
UNDER

Application No. **G.6724** Permit No. **G.5470**.....  
IN NAME OF

...**ALAN M. & RUTH G. INSKO**.....

Surveyed **2-15**..... **19.79**., by **R. Baldwin**.....  
**5-19**                      **82**                      **V. Church**  
**5-7**                         **84**