


G-6785  
54736

T. 4N., R. 28E., W. M.

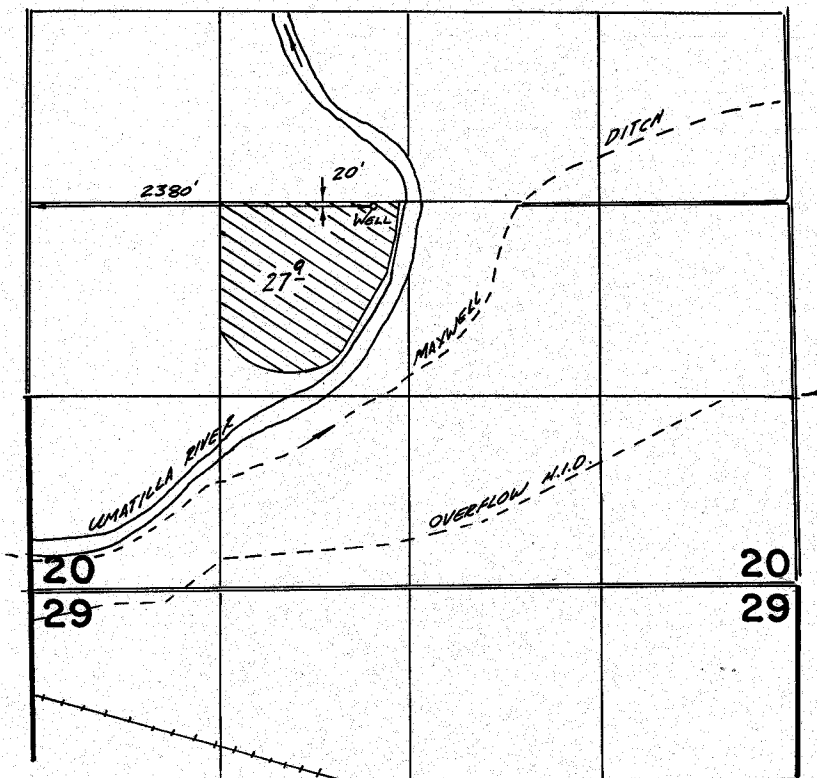

**FINAL PROOF SURVEY**  
UNDER

Application No. **G:5947** Permit No. **G:6785**  
IN NAME OF

**BENJAMIN J. NEWMAN**

Surveyed July 27, 1982, by V.L. Church