


G-7413
54739

T.3N., R.34E., W.M.

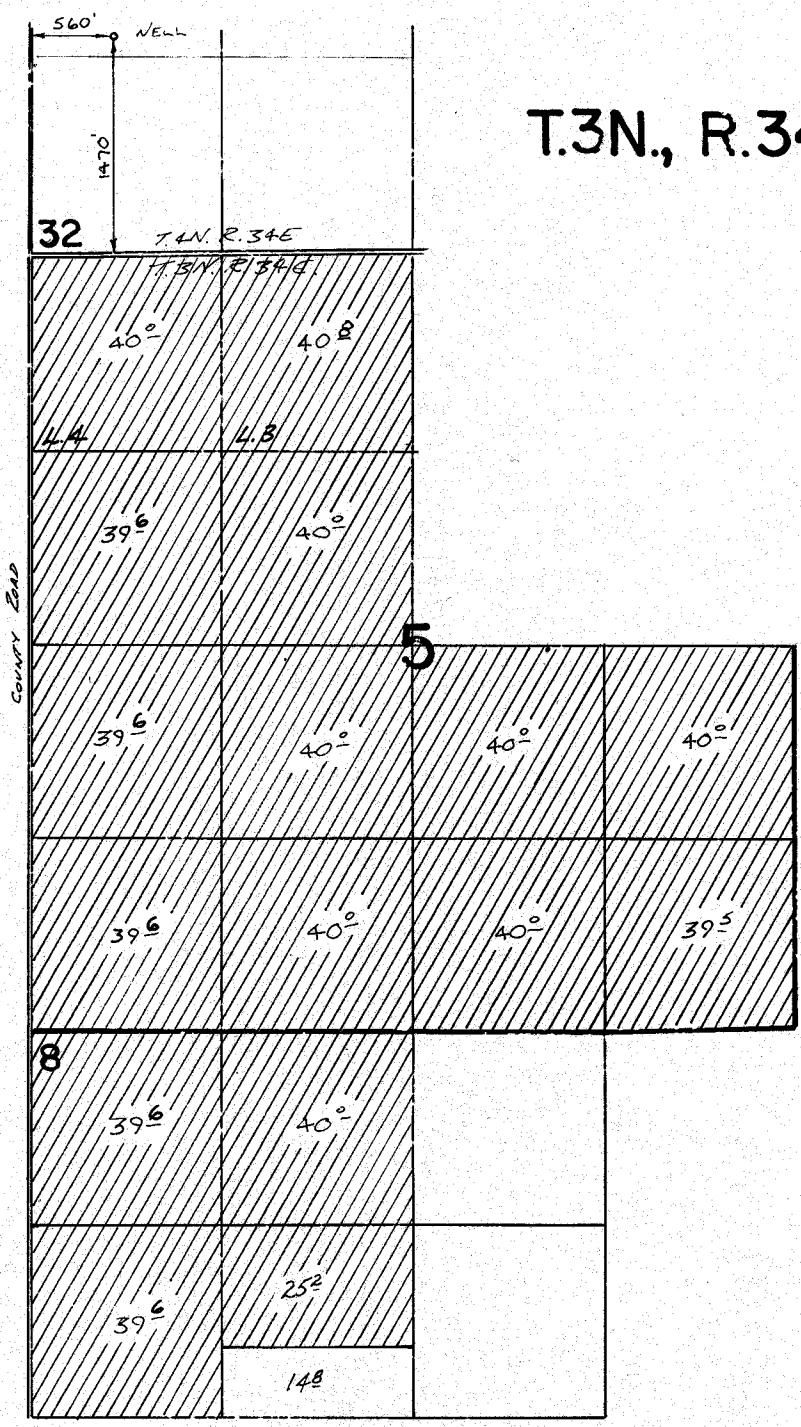

FINAL PROOF SURVEY
UNDER

Application No. G:7991 Permit No. G:7413
IN NAME OF

BARNETT RUGG, INC.

Surveyed Nov. 13, 1981, by V.L. Church