


T.4S. R.12E. W.M.

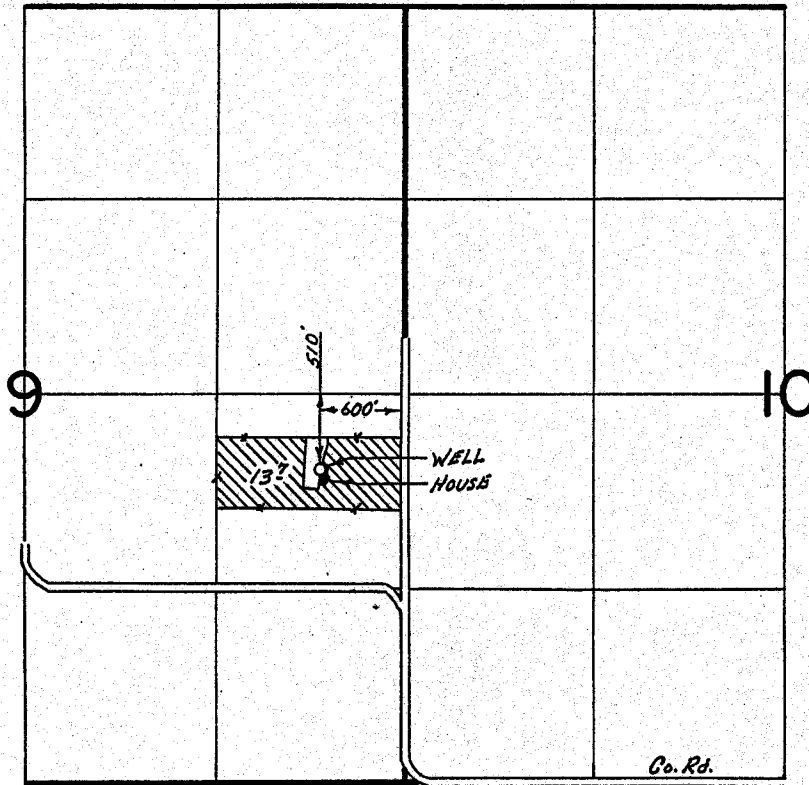

**FINAL PROOF SURVEY**  
UNDER

Application No. G-8907. Permit No. G-8296.  
IN NAME OF

**JAMES W. SCHLAGER & CONNIE M. SCHLAGER**

Surveyed Oct. 26, 1983, by T. J. Paul.