


6-8402

54743

T. 1N., R. 32E., W.M.

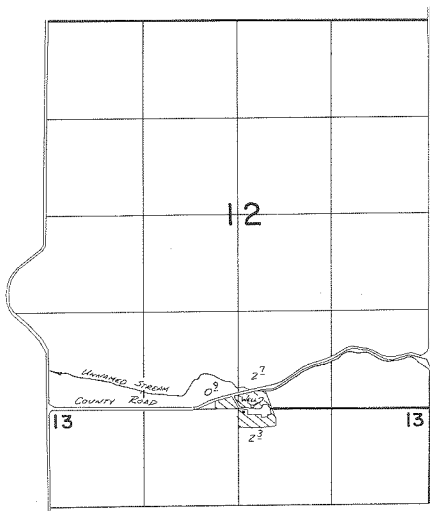

Well Loc: 20' N. + 2450' W. FROM SE COR. SEC 12

FINAL PROOF SURVEY
UNDERApplication No. G:9039 Permit No. G:8402
IN NAME OF

CECIL S. HOLMES

Surveyed May...19... 1982, by V.L. Church...