
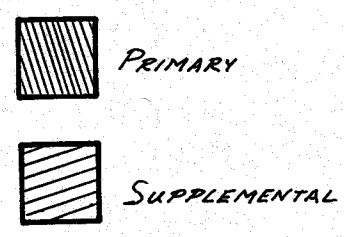


G-8966
54745

T. 6N., R. 35E., W.M.

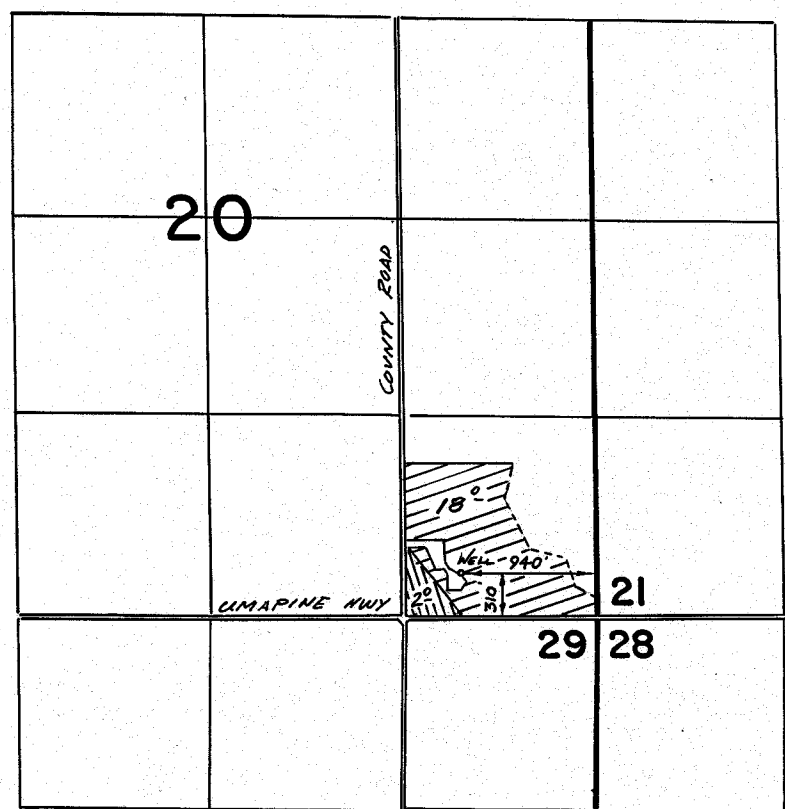

FINAL PROOF SURVEY
UNDER

Application No. **G:9660** Permit No. **G:8966**
IN NAME OF

WAYNE SKRAMSTAD

Surveyed ~~July 8~~ 1987, by *R. L. Church*