


G-9142
54746

T. 5N., R. 29E., WM.

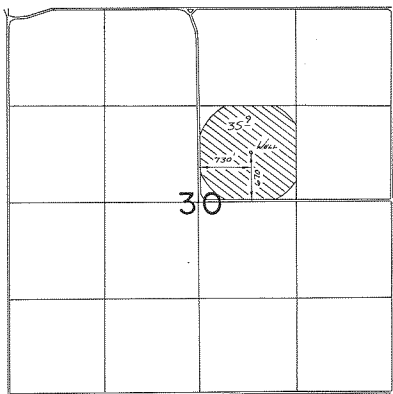

FINAL PROOF SURVEY
UNDER

Application No. G:10039 Permit No. G:9142.
IN NAME OF

ALASTIER P. T. THORNBURG.

Surveyed Aug. 5, 1932, by *J. H. Church*