


6-9188  
54747

T.4N., R.28E., W.M.

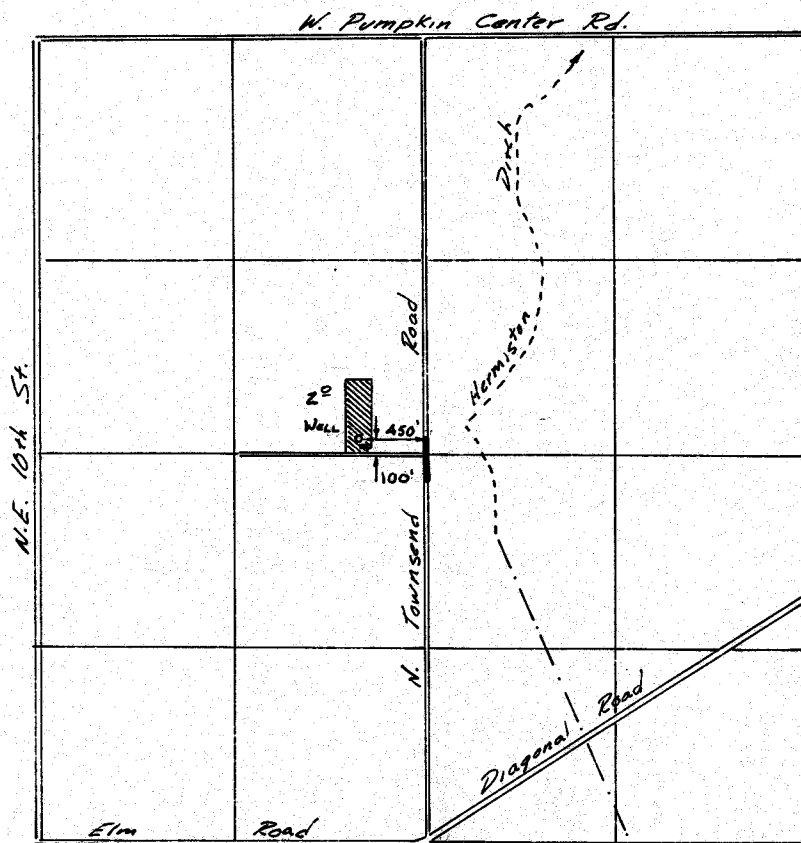

**FINAL PROOF SURVEY**  
UNDER

Application No. G: 9528 Permit No. G: 9188  
IN NAME OF

.....RONALD J. FLINK.....

Surveyed 3-24..... 1983, by K. Church.....