T. 4N., R. 29E., W. M.

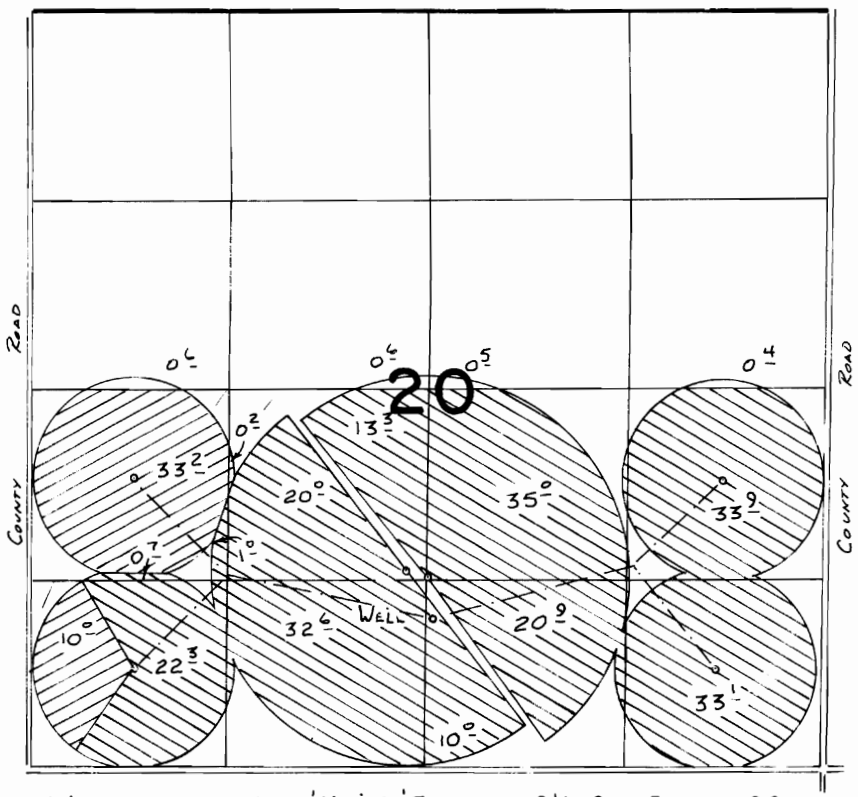

WELL LOCATED 1050'N. & 50'E. FROM S1/4 COR. SECTION 20

Per. G-10429

T-5501

FINAL PROOF SURVEY

UNDER

APPL. G 11289 PER. G-10429
TRANSFER 5501
IN NAME OF

THE TRAVELERS INSURANCE Co.

Surveyed 10-8 3-5 1984 85, by V. L. Church

SCALE: 1" = 1320'

SPECIAL ORDER V. 38 P. 440

PTS-1984-PE

V.L.C.