


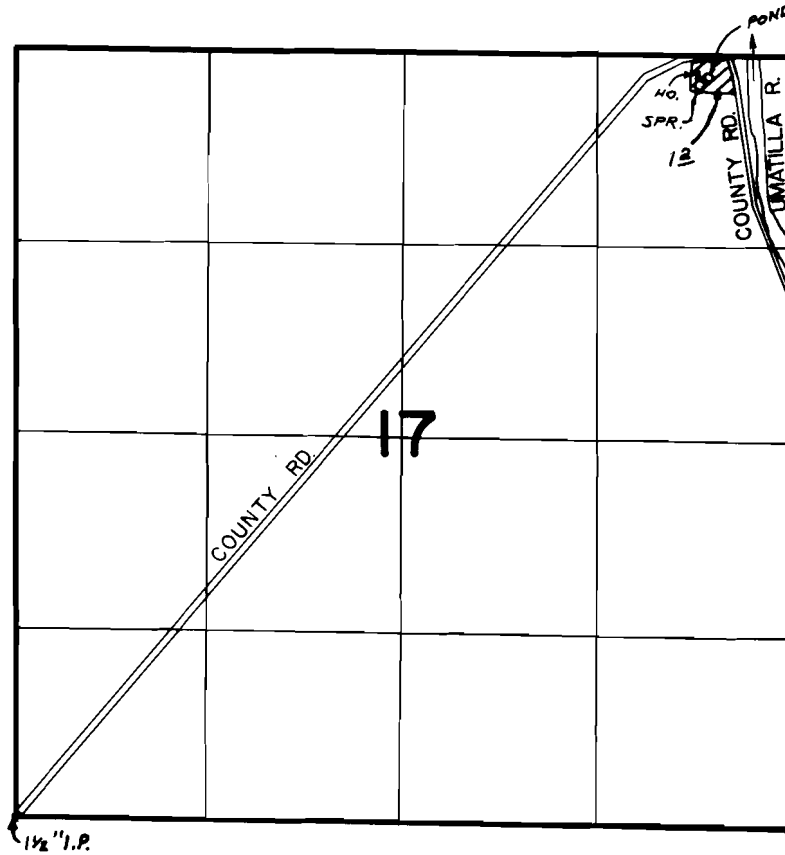

T. 4N. R. 28E. W. M.

SCALE: 4"=1 MILE



SPRING LOCATED 200'S & 630'W FROM NE COR. OF SEC 17

FINAL PROOF SURVEY
UNDER

Application No. 45553... Permit No. 34072...
IN NAME OF

.....**FRED H. HENNEKE**.....

Surveyed 8-11-1978, by R. BARWIN.....
3-26 86 J. Sauter