


T.2&3S.,R.48E.,W.M.

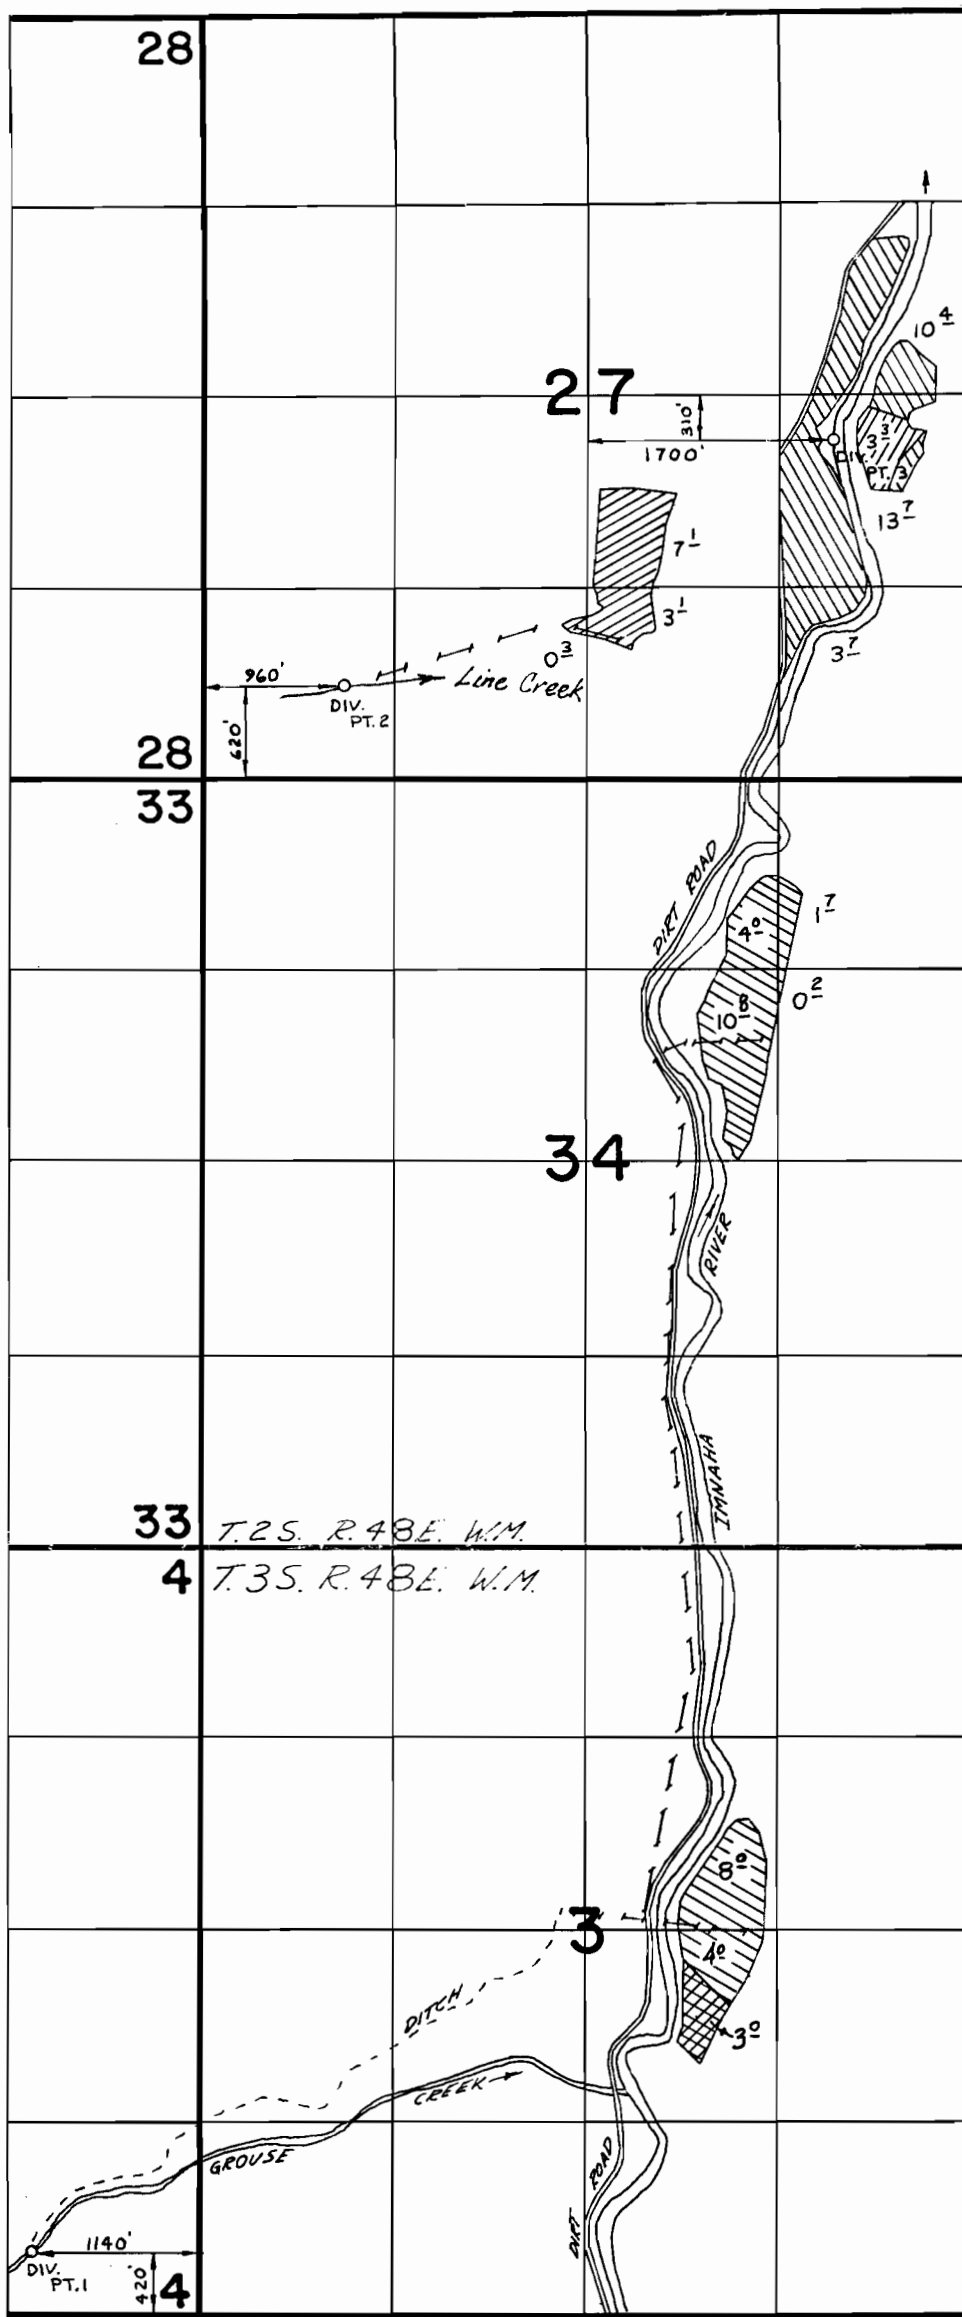

PRIM PER 37669



SUPPL PER 37669



LINE CR. PER. 34371



PRIMARY
GROUSE CR. PER 34371
SUPPLEMENTAL

FINAL PROOF SURVEY UNDER

APPL. 46020 PER. 34371
50135 37669

IN NAME OF
CIRCLE M. CATTLE CO.

SURVEYED 8 31, 1978 by R. BARWIN