



T. 5N. R. 28E. W.M.

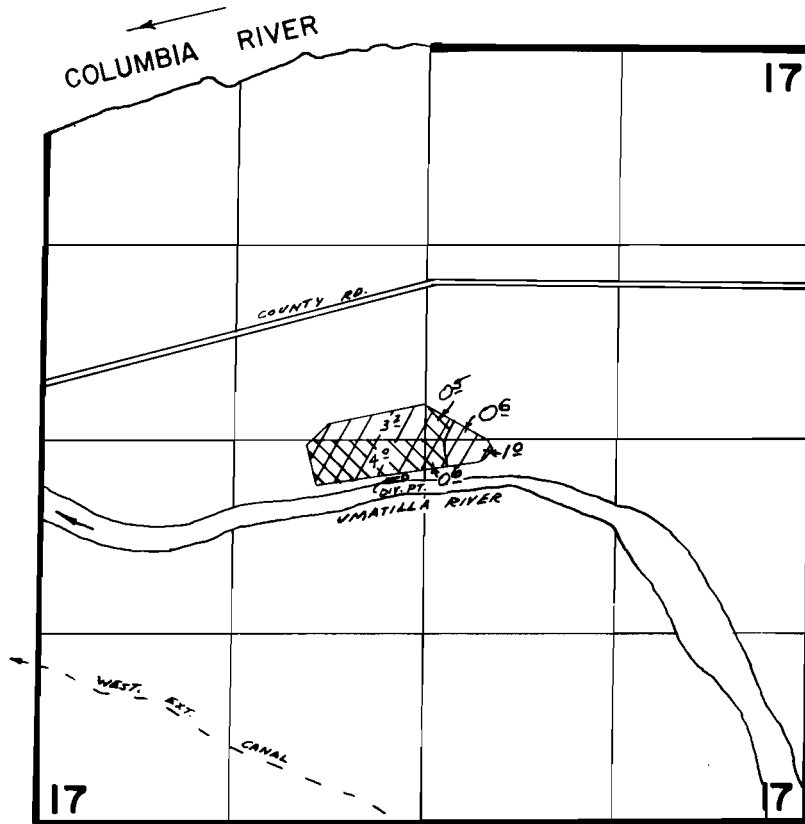

DIV. PT. LOC. 240'S & 140'W FROM CENTER SEC 17

 - Primary

 - Supplemental

FINAL PROOF SURVEY UNDER

Application No. 55968 Permit No. 41935
IN NAME OF

UMATILLA SCHOOL DIST.

Surveyed 10-5 1978, by R. BARWIN