


G-9546

34777

T. 1S., R. 32E., W.M.

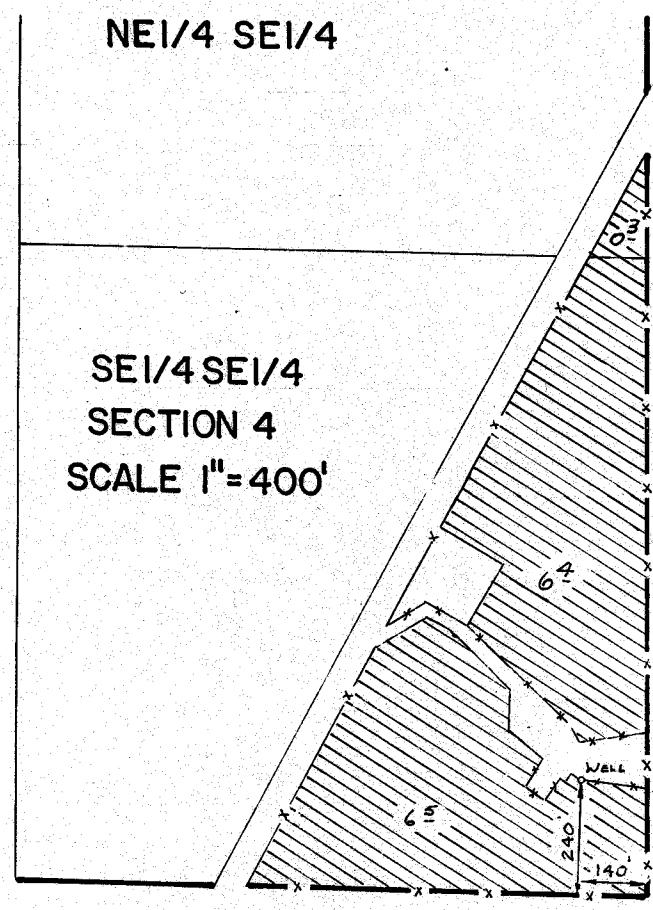

FINAL PROOF SURVEY UNDER

Application No. G:9837 Permit No. G:9546...
IN NAME OF

.....JOHN.....R.....TAYLOR.....

Surveyed May...23... 1983, by *Harmon Church...*