


T.26S. R.1W. W.M.

Springs Located:
 1- 330' S & 1460' E
 2- 420' S & 1080' E
 3- 740' S & 130' E
 4- 10' S & 1080' E
 5- 180' N & 1620' E
 from the W/4 cor. Sec. 9

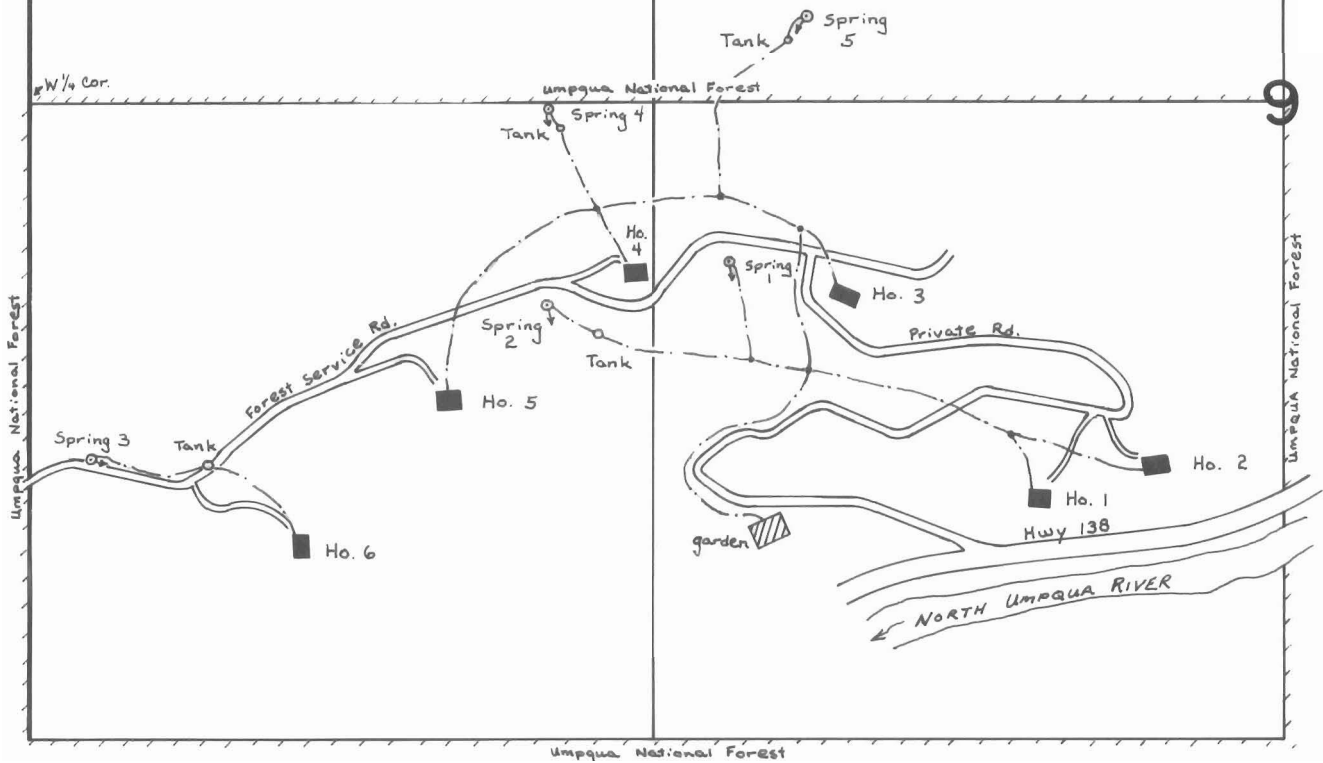

FINAL PROOF SURVEY UNDER

SCALE: 1" = 400'

Application No. 46420 Permit No. 34685.....
 IN NAME OF

FRANK & JEANNE MOORE

Surveyed May 6..... 1980., by S. Donaldson.....