


T. 30S., R. 6W., W.M.

SEC. 33

NWSW

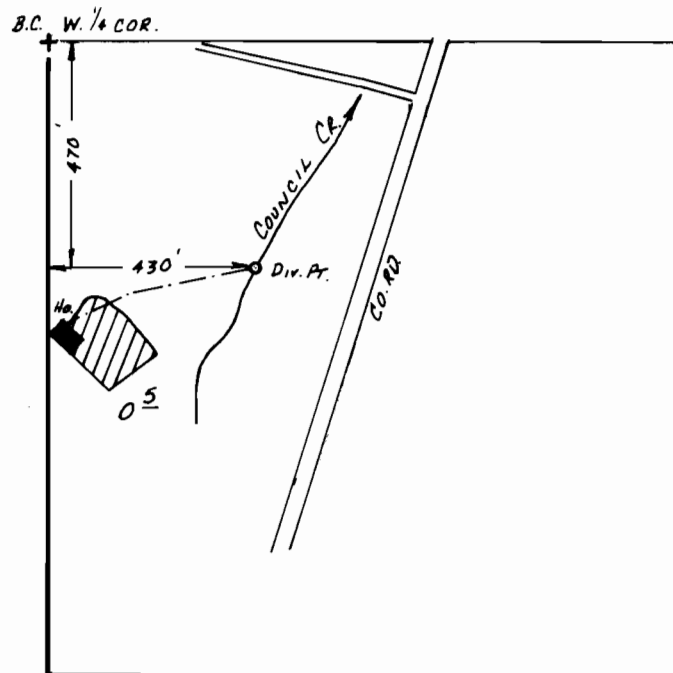

SCALE: 1" = 400'

**FINAL PROOF SURVEY**

UNDER

Application No. 51923.... Permit No. 37819.....

IN NAME OF

...FLOYD J. & NEPIE M. CONDREY

Surveyed JUNE 23, 1980, by J.S. DONALDSON