


T.26S. R.2E. W.M.

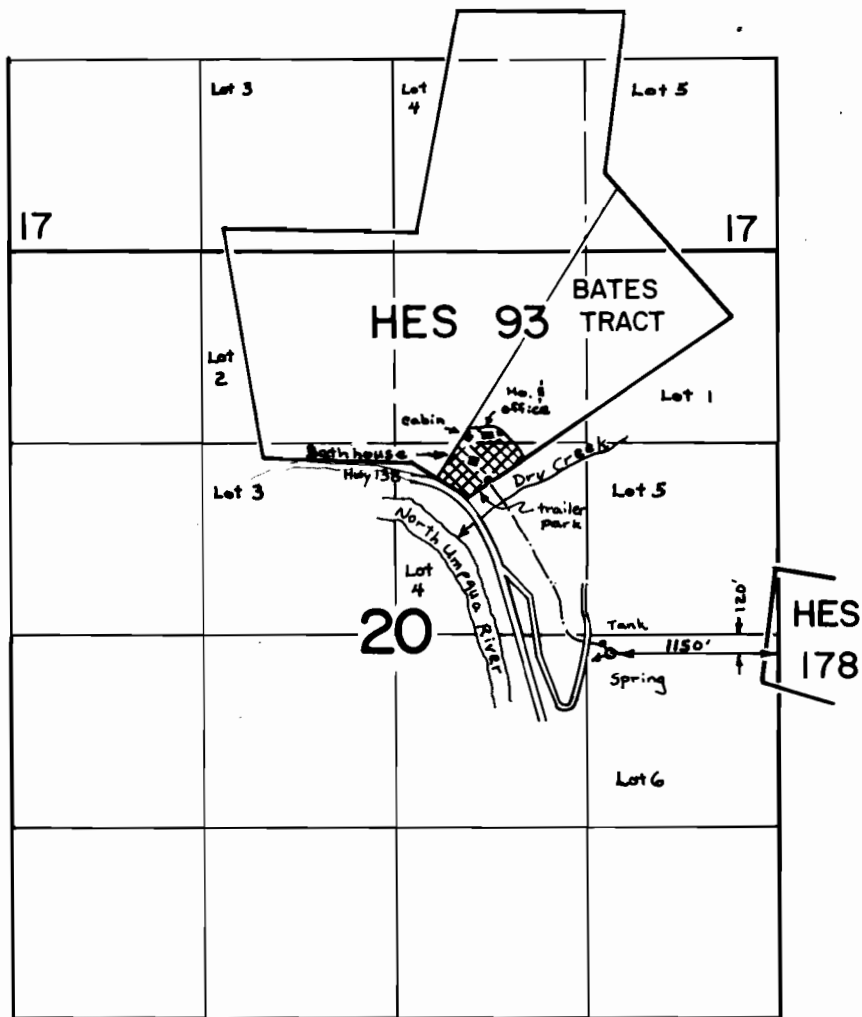

SCALE: 4" = 1 mile

**FINAL PROOF SURVEY**  
UNDER

Application No. 50049 Permit No. 38083  
IN NAME OF

STANLEY D. HAYS

Surveyed May 7, 1980, by S. Donaldson