


T.22 S. R.7W. W.M.

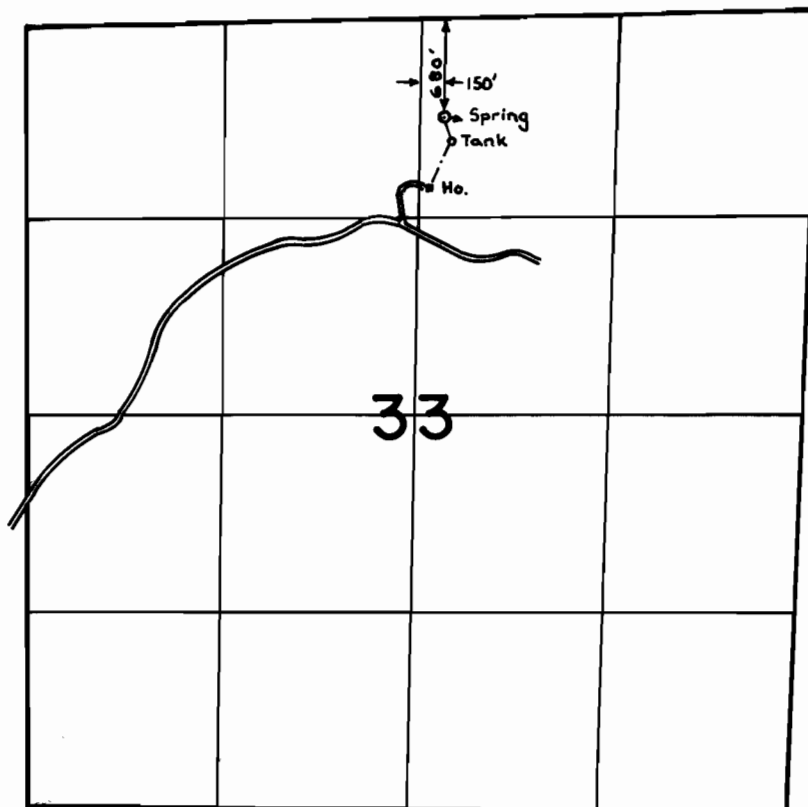

SCALE: 4" = 1 mile

FINAL PROOF SURVEY
UNDER

Application No. 51110 Permit No. 38559
IN NAME OF

JOHN E. SHERRY BREED

Surveyed Aug. 23, 1979, by S. Donaldson