


T.28S.,R.4W.,W.M.

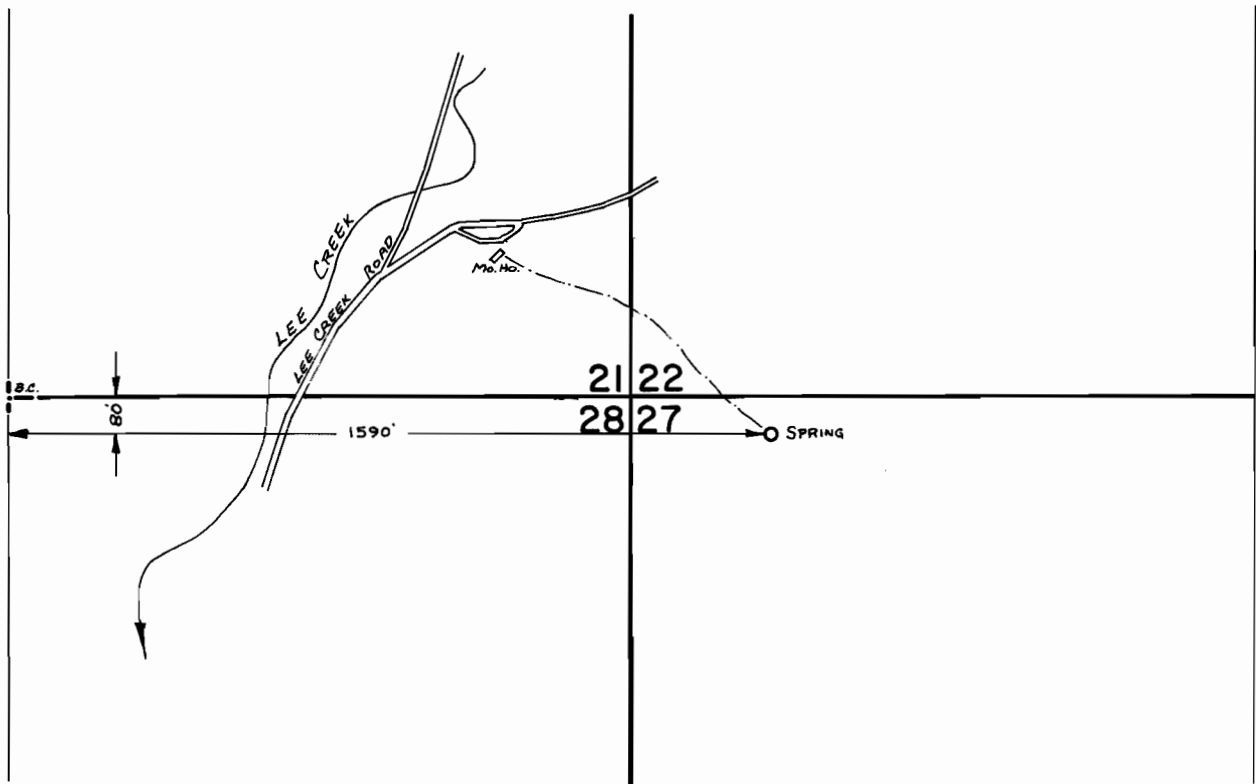

SCALE: 1" = 400'

FINAL PROOF SURVEY
UNDER

Application No. 51303 Permit No. 38738
IN NAME OF

RAYMOND L. ASHWOOD

Surveyed June 11 1980, by J. S. DONALDSON