


# T. 30 S., R. 5 W., W. M.

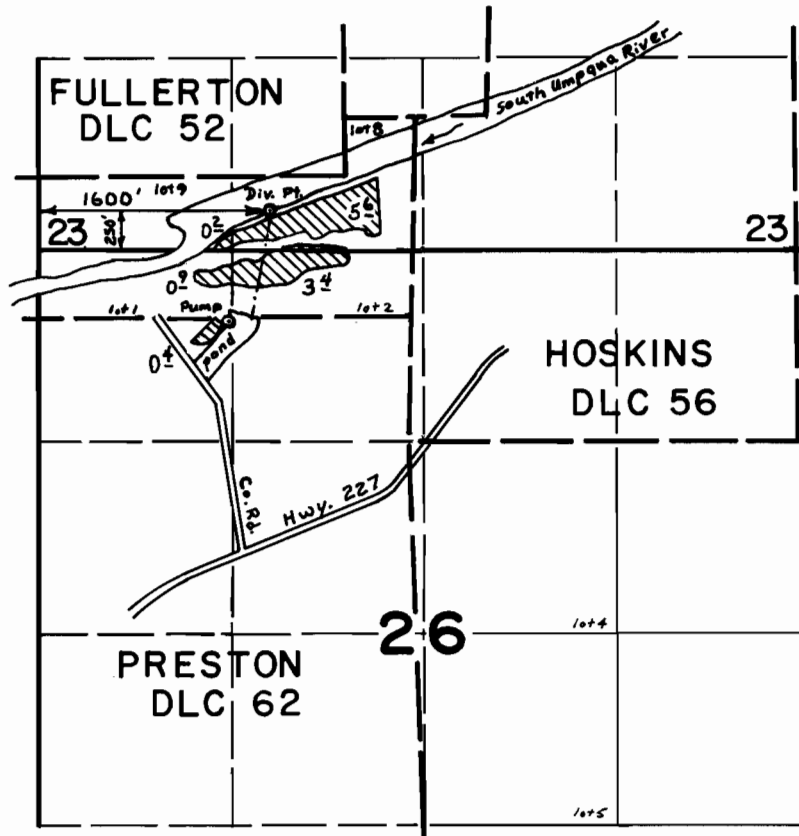

SCALE 4" = 1 mile

## FINAL PROOF SURVEY UNDER

Application No. 523.01... Permit No. 393.45.  
IN NAME OF

..... BENNETT, A. S. PICKETT, T. ....

Surveyed March 8, 1979, by S. Donaldson...