


T. 27S., R. 7W., W.M.

SEC. 2

SE1/4 NE1/4

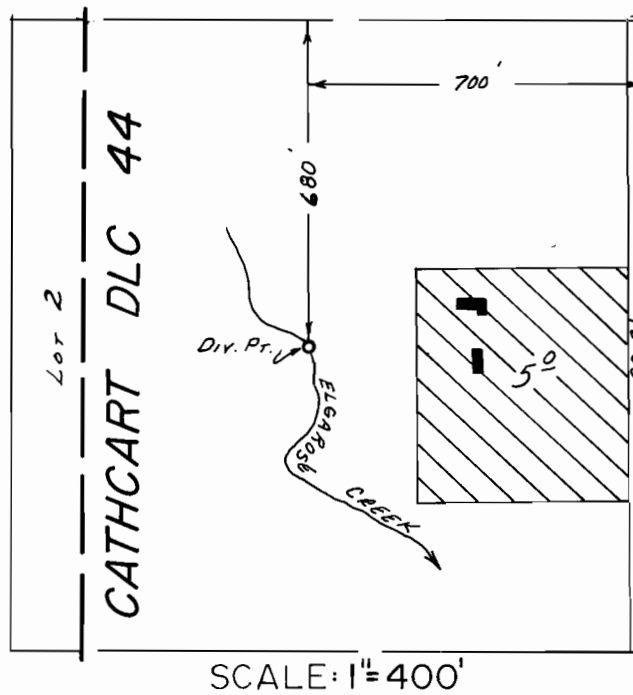

FINAL PROOF SURVEY
UNDER

Application No. 53271.... Permit No. 39532.....
IN NAME OF

.....**JOE W. REED**.....

Surveyed MAR. 31, 1980., by J. S. DONALDSON