


T.27S., R.7W., W.M.

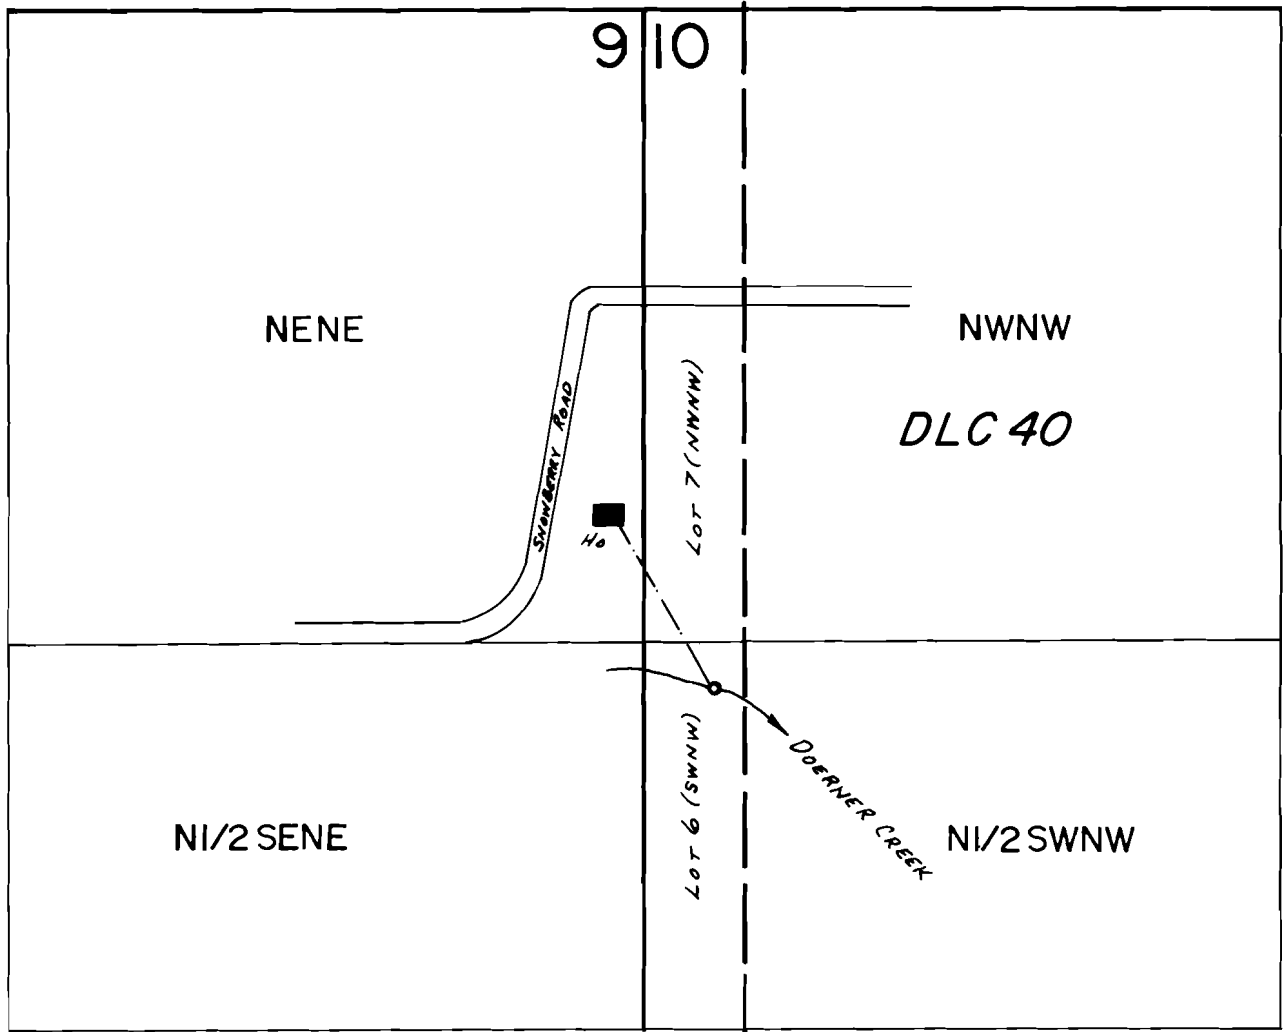

DIV. PT. LOC.: 1410' S. & 150' E. FROM NW COR. SEC. 10

SCALE: 1" = 400'

**FINAL PROOF SURVEY**  
UNDER

Application No. 53426.. Permit No. 39756.....  
IN NAME OF

.....THOMAS E. TIPTON.....

Surveyed MAR. 31... 1980... by J. S. DONALDSON