


T. 26S., R. 7W., W.M.

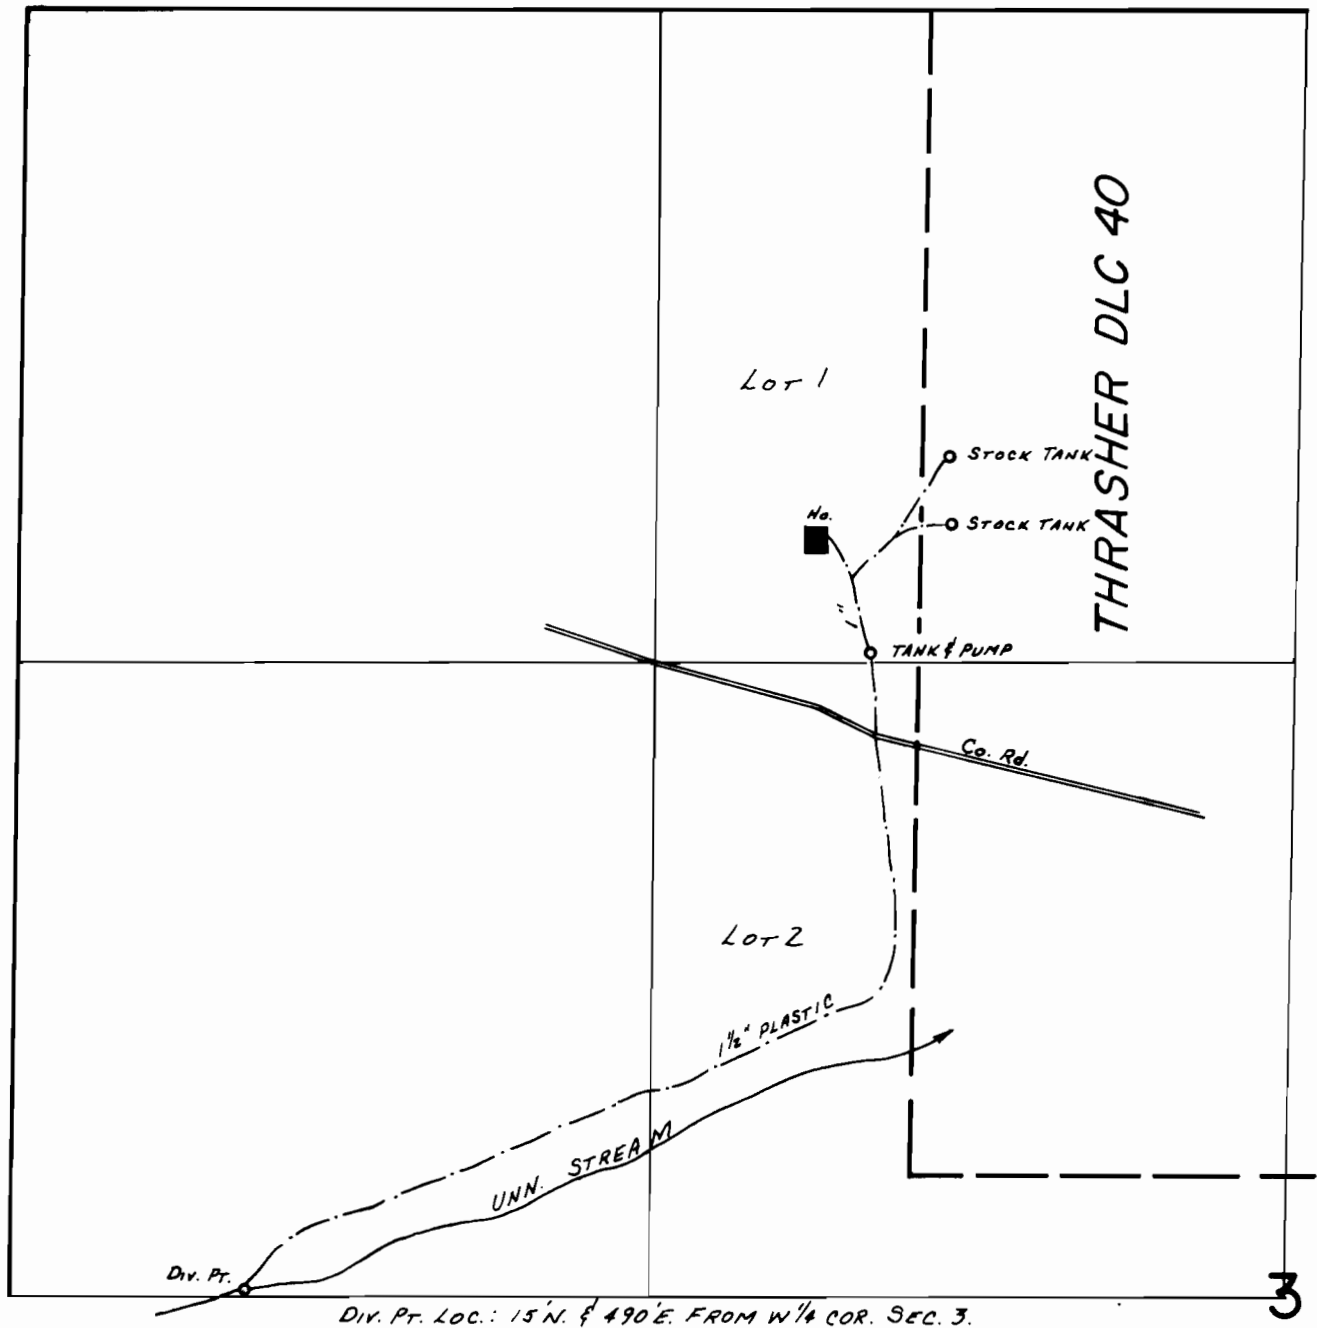

DIV. PT. LOC.: 15' N. & 490' E. FROM W 1/4 COR. SEC. 3.

SCALE: 1" = 400'

FINAL PROOF SURVEY
UNDER

Application No. 53706... Permit No. 40275...
IN NAME OF

.....ARCHIE L. CLARNO.....

Surveyed MAR. 26, 1980., by J.S. DONALDSON