


12.1
0.0002

T 20S
R 10W
Section 5
990'

NE Cor lot 8
Sec. 5

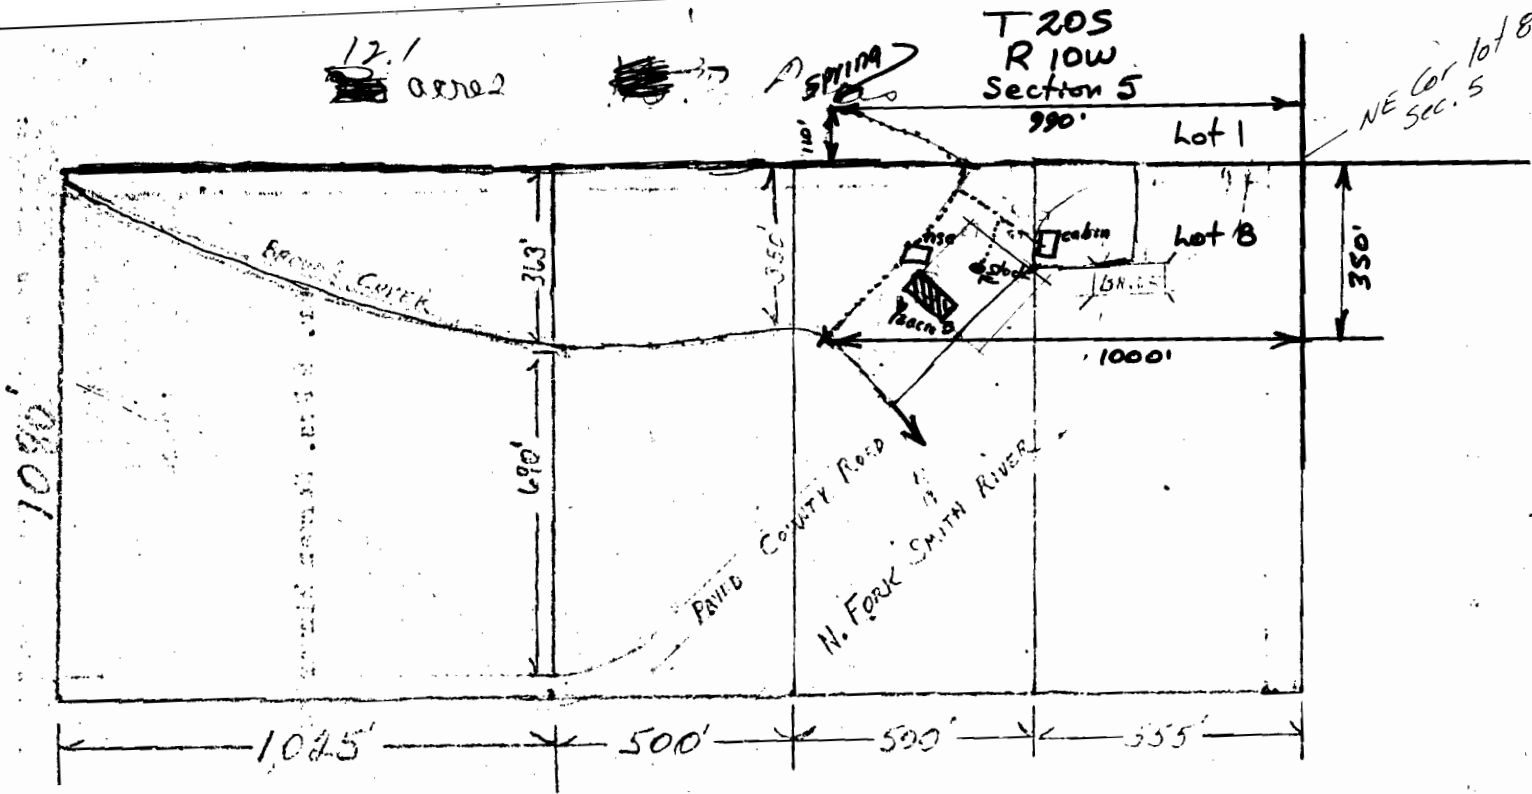

RECEIVED

Application No. 54723
Permit No. 41052

Scale
1" = 400'

