


T. 26 S. R. 5 W. W.M.

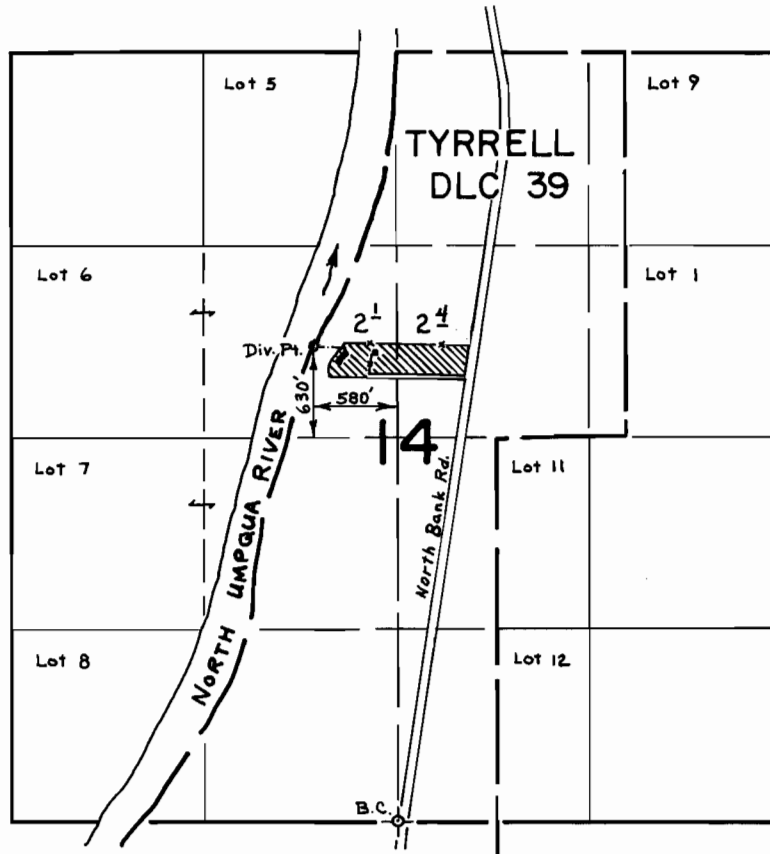

ECHO BEND RANCH
Lot 56

SCALE: 4" = 1 mile

FINAL PROOF SURVEY
UNDER

Application No. 54975. Permit No. 41257.....
IN NAME OF

J. R. REES

Surveyed March 19, 1980., by S. Donaldson.....