


T. 23S., R. 10W., W.M.

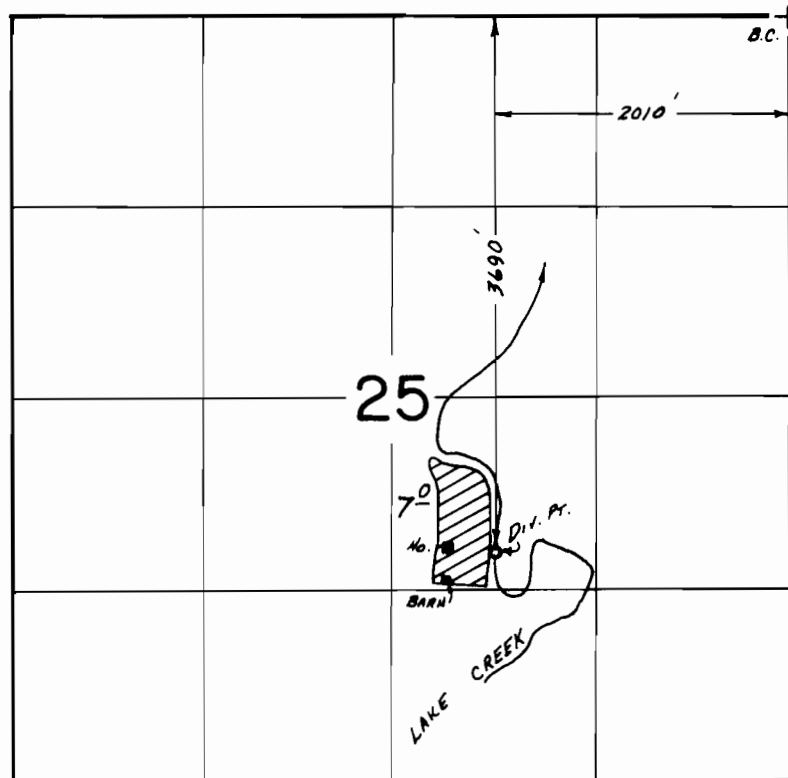

FINAL PROOF SURVEY
UNDER

Application No. 55311... Permit No. 41639...
IN NAME OF

...PHILLIP G. & VERA A. KOCH...

Surveyed JUNE 4... 1980, by J.S. DONALDSON