


T. 27S., R. 6W., W.M.

SEC. 15

NESE

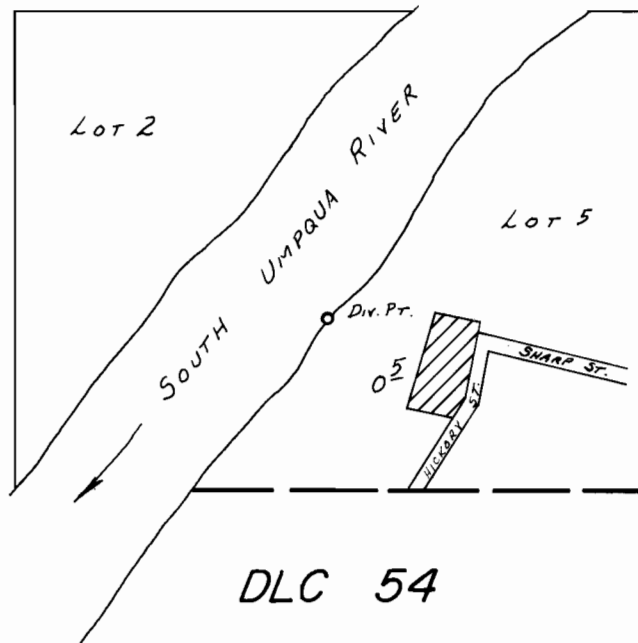

DIV. PT LOC.: 640'S. & 660' W. FROM NE COR. LOT 5.

SCALE: 1" = 400'

**FINAL PROOF SURVEY**  
UNDER

Application No. 55515... Permit No. 41843...  
IN NAME OF

..... JAMES S. EVANS .....

Surveyed MAR. 18... 1980., by J. S. DONALDSON