




T.30S.,R.4W.,W.M.

SECTION 6

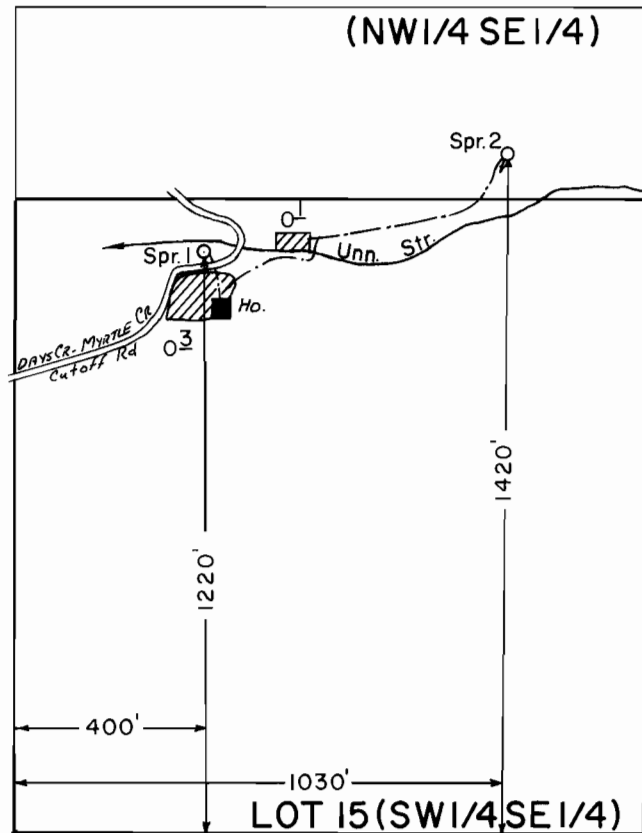

SCALE: 1" = 400'

FINAL PROOF SURVEY
UNDER

Application No. 57252 Permit No. 43063
IN NAME OF

FREDA E. BARROW

Surveyed June 26, 1980, by J. S. DONALDSON