


T. 21 S., R. 12 S., W. M.

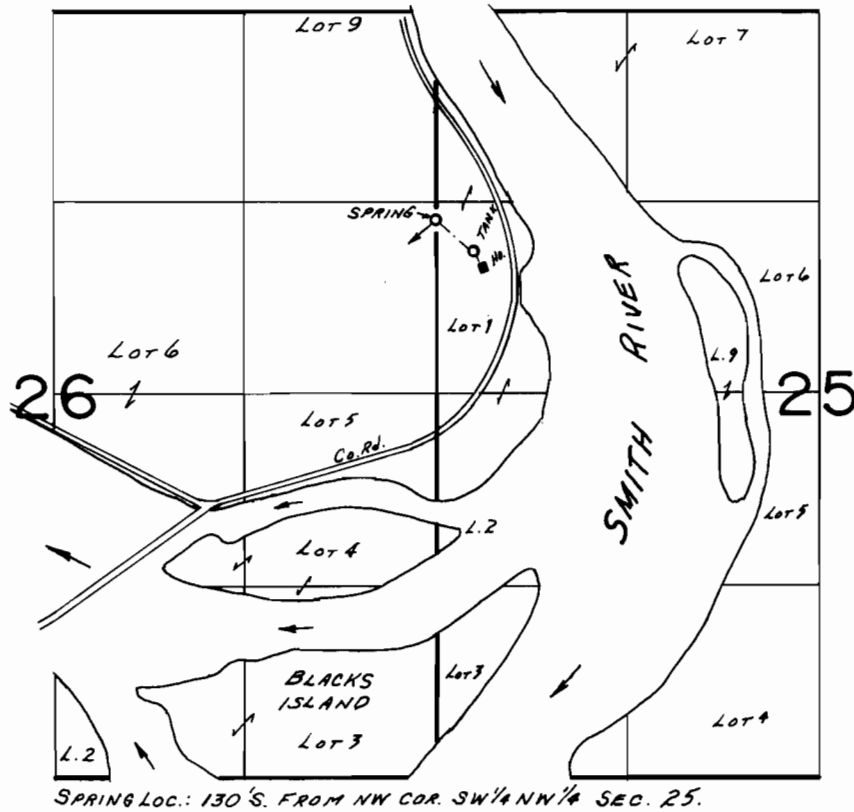

FINAL PROOF SURVEY
UNDER

Application No. 57548... Permit No. 43362.....
IN NAME OF

.....GERALD A. REAVIS.....

Surveyed JUNE 2... 19.80., by J.S. DONALDSON