


T.26S. R.5W. W.M.

Sec. 26

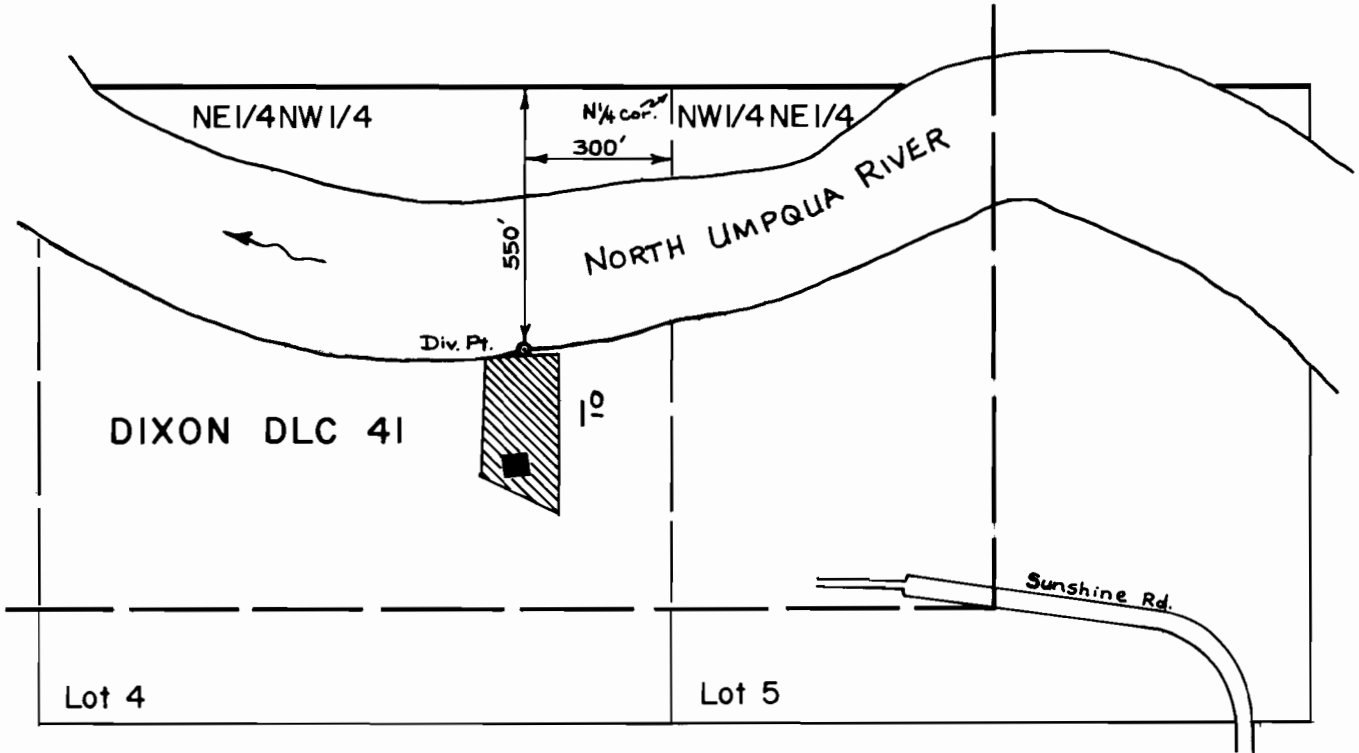

OAK-LAWN ACRES
Lot 10

SCALE: 1" = 400'

FINAL PROOF SURVEY

UNDER

Application No. 57757 Permit No. 43489
IN NAME OF

.....Theresa A. Shipley-Klein.....

Surveyed March 17, 1980, by S. Donaldson...