


T.2N., R.8E., W.M.

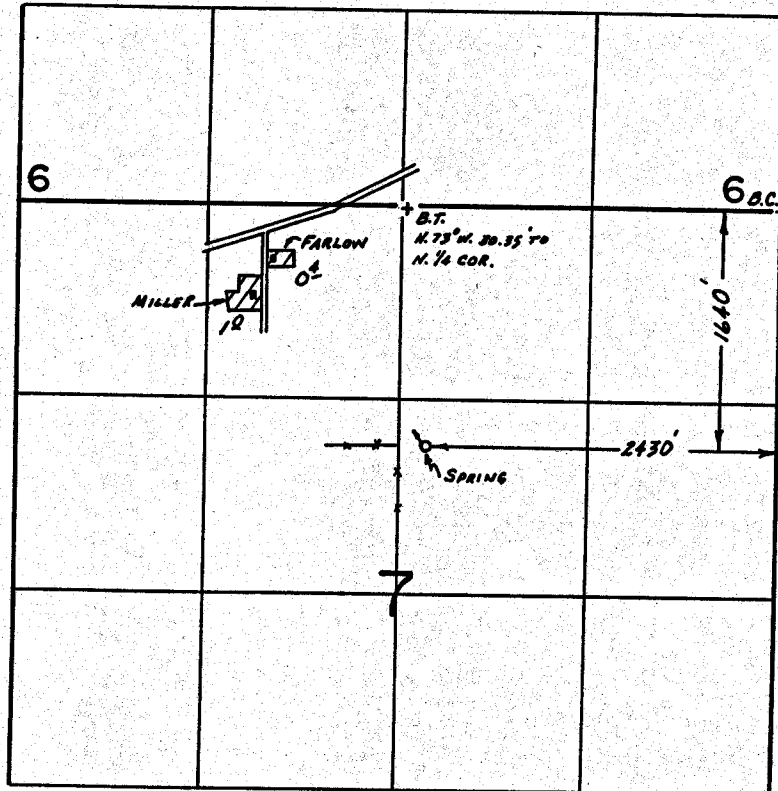

FINAL PROOF SURVEY

UNDER

Application No. 58986... Permit No. 44312.....
 IN NAME OF

LEAFORD W. & FLORENCE M. MILLER & ELDON F. FARLOW

Surveyed SEPT. 23. 1981., by L. M. TOLL.....