



T.2N., R.8E., W.M.

SEC. 7

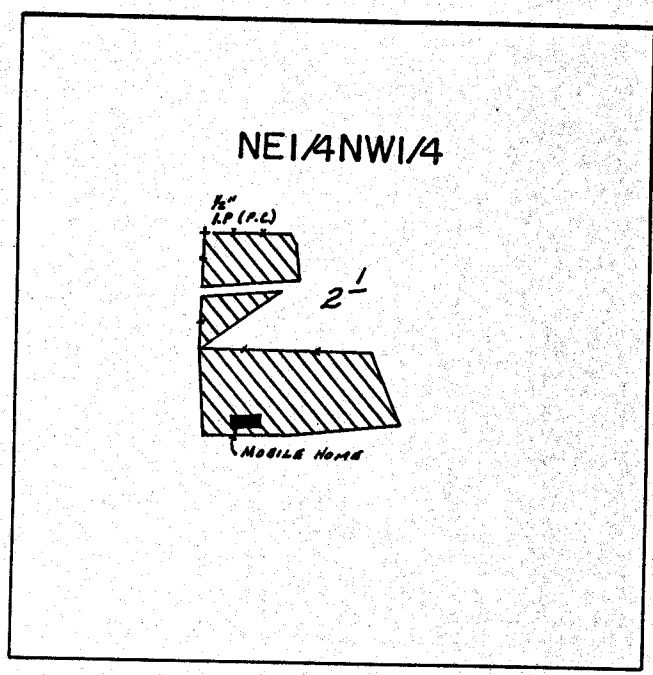

1" = 400'

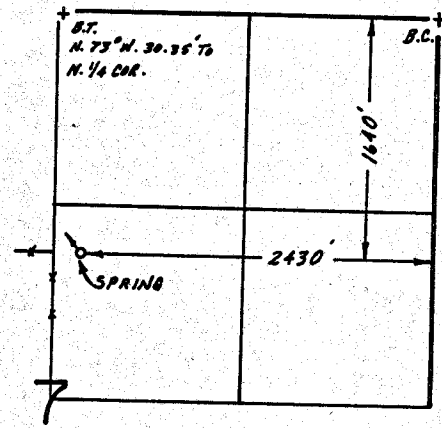

1" = 1320'

FINAL PROOF SURVEY UNDER

Application No. 60529. Permit No. 46189.....
IN NAME OF

.....IRENE RAE (FAGIN) JOHNISEE.....

Surveyed Aug. 29. 1985, by T.M. WARREN.....