


T. 39S., R. 3W., W.M.

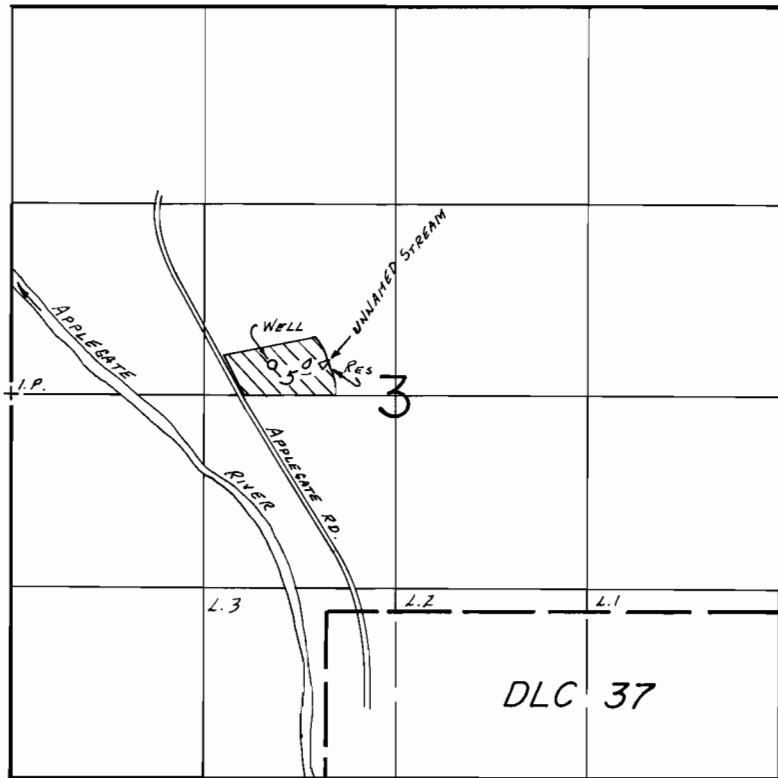

DIV. PT. LOC.: 190' N. & 2120' E., WELL LOC. 200' N. & 1790' E., BOTH FROM W 1/4 COR. SEC. 3.

SCALE: 1" = 1320'

### FINAL PROOF SURVEY UNDER

G-8409                      G-7775  
R-55448                    R-6753

Application No. 55449 Permit No. 42593.....  
IN NAME OF

CALVIN L. & VELMA E. REISINGER

Surveyed July 3..... 19.85, by B.S. JAMES.....  
                  Aug. 12