


T.39S., R.3W., W.M.

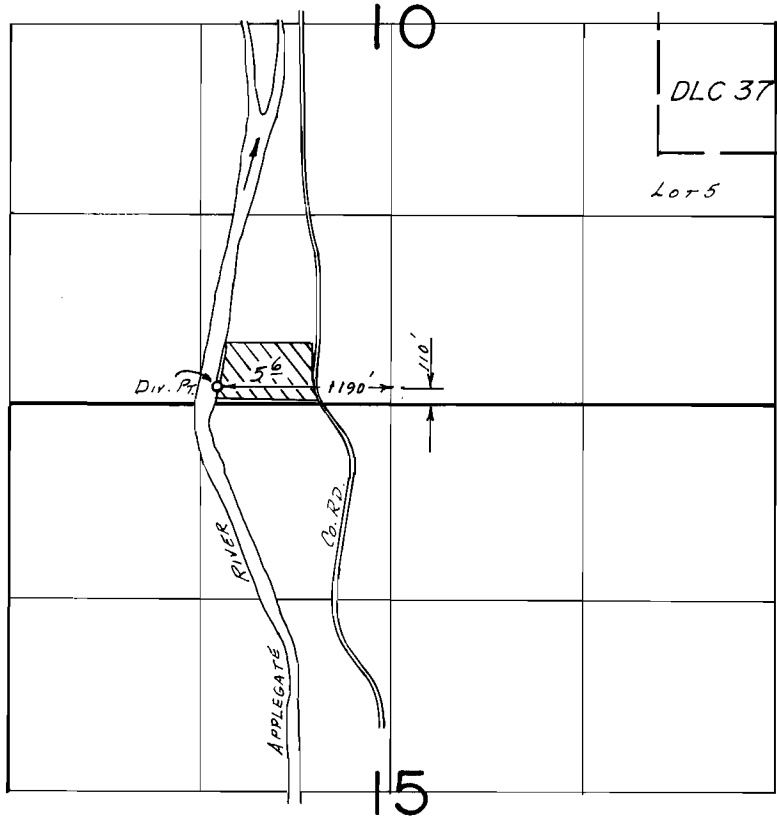

SCALE: 1" = 1320'

**FINAL PROOF SURVEY**  
UNDER

Application No. 62116... Permit No. 46350.....  
IN NAME OF

.....CHARRIE A. KAUFMAN.....

Surveyed July 3... 1985, by B.S. JAMES.....