


# T. 37 S., R. 2 W., W.M.

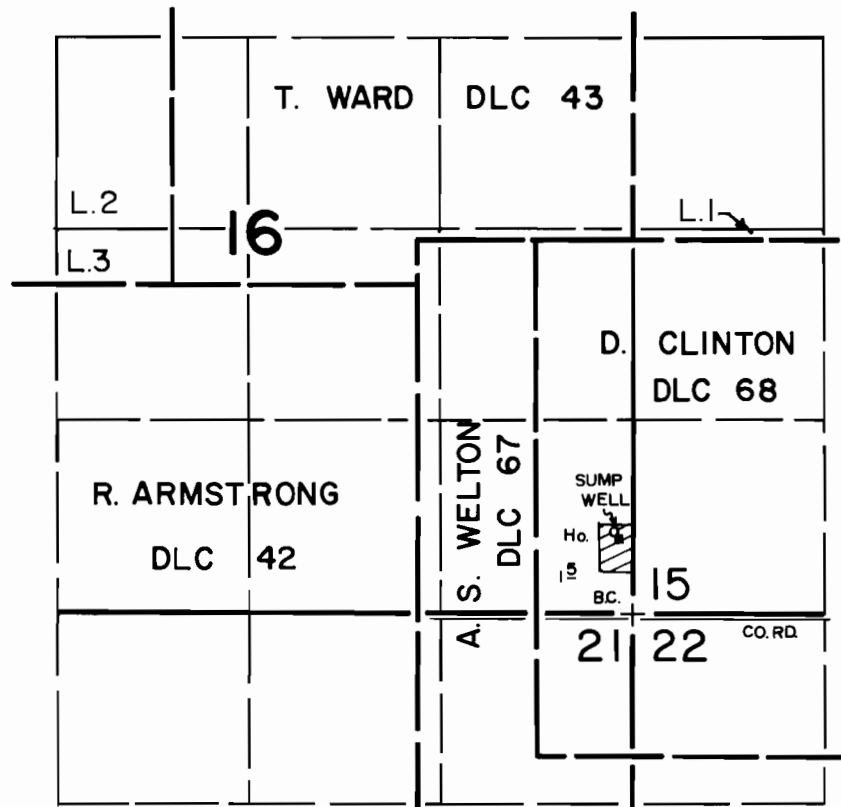

SUMP WELL LOC: 560' N & 130' W FROM SE COR. Sec. 16

## FINAL PROOF SURVEY UNDER

Application No. G-7445 Permit No. G-7254

IN NAME OF

MANFRED R. & BARBARA A OLSON and  
SUSAN O. WALDEYER

Surveyed Oct. 21, 1982, by B.S. JAMES

Scale: 4" = 1 mile

279-277 R